

# JUNEAU COUNTY SURVEY MONUMENT RECORD

CORNER NO. 1  
SECTION 6  
TOWN 18 N.  
RANGE 2 E.

TYPE OF MONUMENT: 2" DIAMETER IRON PIPE FOUND


JUNEAU COUNTY COORDINATES NAD 83/91  
NORTHING: 255,918.98  
EASTING: 400,869.55

■ = CORNER MONUMENT RESTORED

BASIS FOR MONUMENT LOCATION  
(USE REVERSE SIDE IF NECESSARY)

SHOW INFO SUCH AS: HISTORY OF CORNER, WITH REFERENCE TO VOLUME AND PAGE DATES, SURVEYOR; EXACT DESCRIPTION OF MONUMENT PLACED OR FOUND, IF LOCATION COMPUTED, BY TAPED OR EDM TRAVERSE; LANDOWNER REMARKS, ETC.

2" DIAMETER IRON PIPE MONUMENT FOUND AS PER TIE SHEET DATED 2/15/1998 BY JAMES CARROLL.

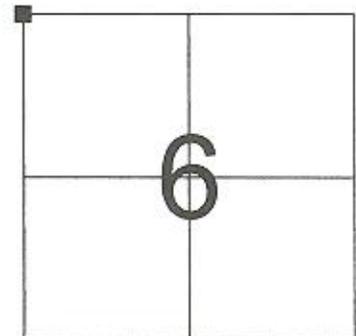


LOCATION

## LEGEND

- = 2" DIAMETER IRON PIPE FOUND
- λ = GOVERNMENT SIGN SET
- = 3/4" X 24" IRON ROD SET

TIE SKETCH  
(SHOW AT LEAST FOUR TIES)

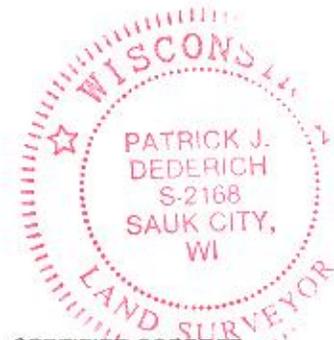

CERTIFIED CORRECT

*Patrick J. Dederich*


REGISTERED LAND SURVEYOR

DATE 4/18/2010

NOT TO SCALE



AZIMUTHS ARE BASED  
ON THE JUNEAU COUNTY  
COORDINATE SYSTEM  
UNLESS OTHERWISE NOTED

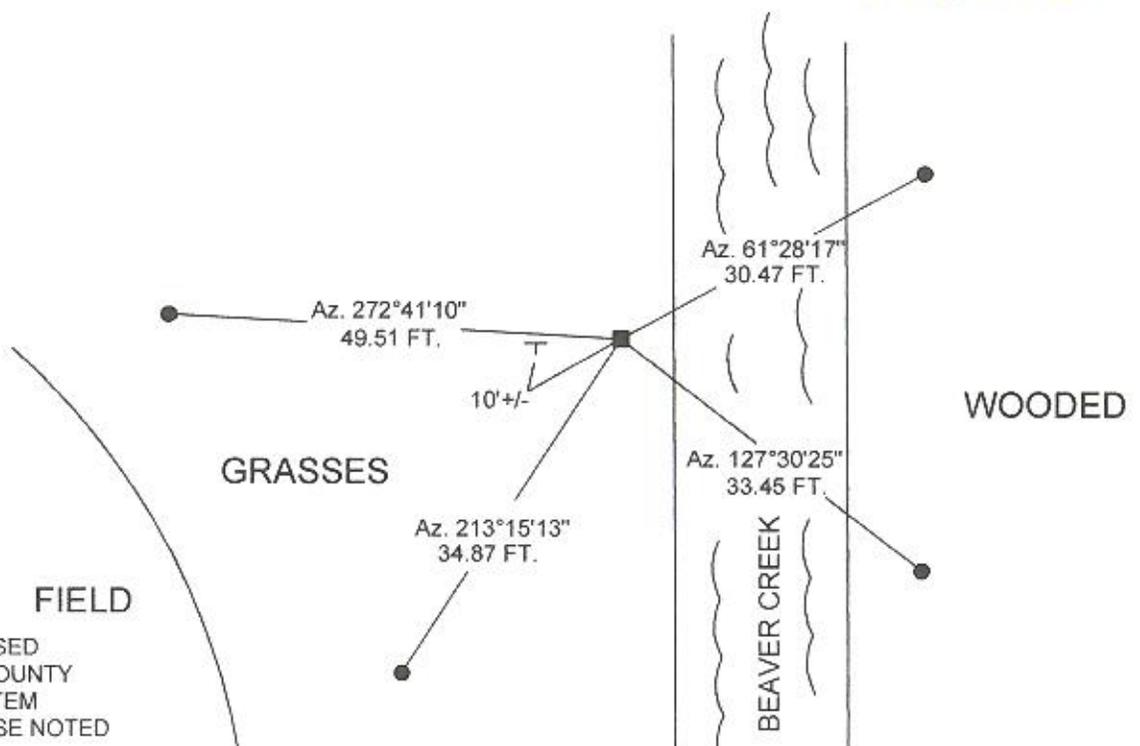

JUNEAU COUNTY

Survey Monument Record

TYPE OF MONUMENT: 2" PIPE

STATE PLANE COORDINATES: N \_\_\_\_\_

E \_\_\_\_\_

ELEVATION — M.S.L. DATUM: \_\_\_\_\_

THETA ANGLE: \_\_\_\_\_


FIELD BOOK: \_\_\_\_\_ PAGE \_\_\_\_\_

CORNER NO. 1

SECTION 6

TOWN 18

RANGE 2E

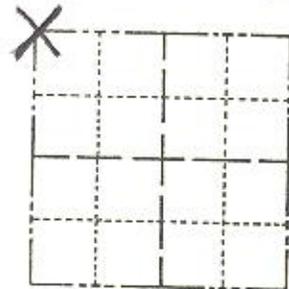

LOCATION  
(Indicated by 'X')

SEAL:



BASIS FOR MONUMENT LOCATION

(Use reverse side if necessary)

Show info such as: History of corner, with reference to Vol. and pg. dates, surveyor; exact description of monument replaced; if location computed, by taped or EDM traverse; landowner remarks, etc.

Monroe County marker found in place.  
Accepted as the true corner location.


CERTIFIED CORRECT

*James J. Carroll*  
Registered Land Surveyor

DATE: Feb. 15, 1988

TIE SKETCH

(Show at least four ties)

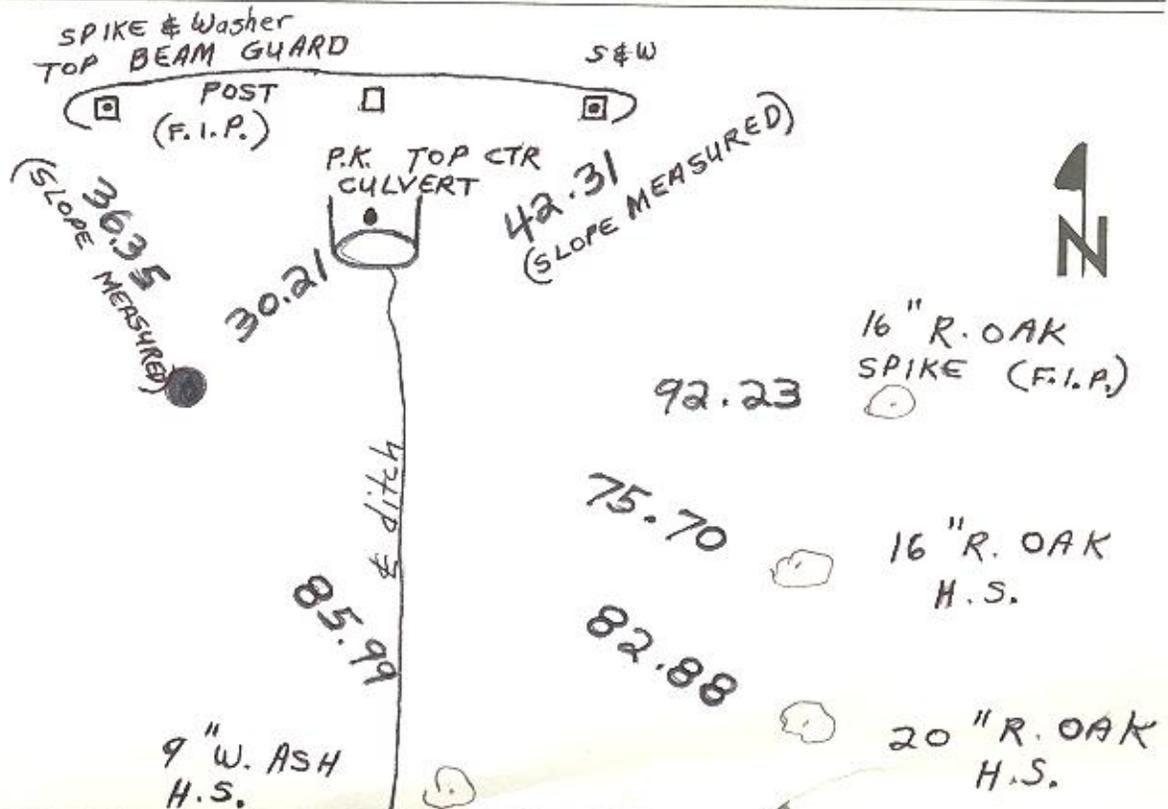

41901360000

I, William C. Jung, do hereby certify that on the 14th day of May 1982, I found ~~evidence~~ (no evidence) of the SE corner of Section 36, T 19 N, R 1 E Fourth Principal Meridian, and I re-established said corner according to the Wisconsin Statutes as shown and described hereon.

Dated this 22nd day of Feb. 1983.

William C. Jung

Deputy County Surveyor  
Title

History of corner establishment since Original Government Survey  
Kennedy's notes of May 19, 1937, state that he set a pipe at this corner, South and West of the concrete culvert, and on the West bank of the ditch.

Description of corner evidence found:

The old culvert was removed and replaced. Obviously Kennedy's pipe was destroyed during construction or grubbing. I set the corner on line with the SW and S1/4 of Section 36 and at a distance from the S1/4 equal to the distance between the SW and S1/4. This location fits the evidence, monuments, and field conditions very well in all four cardinal directions. I did not use double proportionate measurement in this case as I did not think it to be applicable under these conditions. Judging by its final location, I am of the opinion that my corner location marks that of Kennedy's.


Description of corner and witness monuments, references and accessories used to perpetuate the original or re-established location of this corner:

Set N&C on top of guard rail post


Witnesses to corner location:

William Jung


Gary Dechant

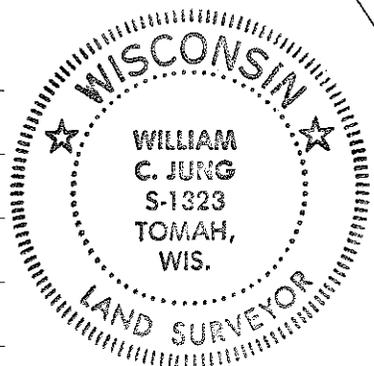

Set 2 1/2"x9.7' iron pipe, up 3.2' on the West side of the creek

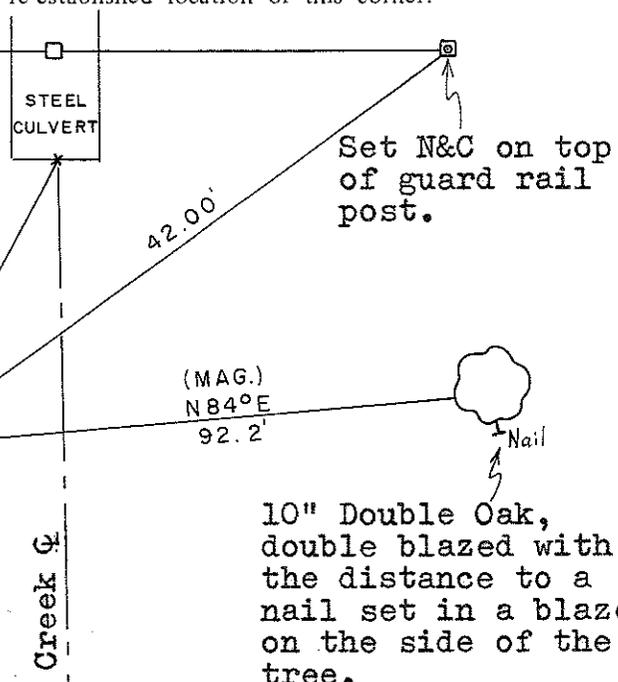

10" Double Oak, double blazed with the distance to a nail set in a blaze on the side of the tree.

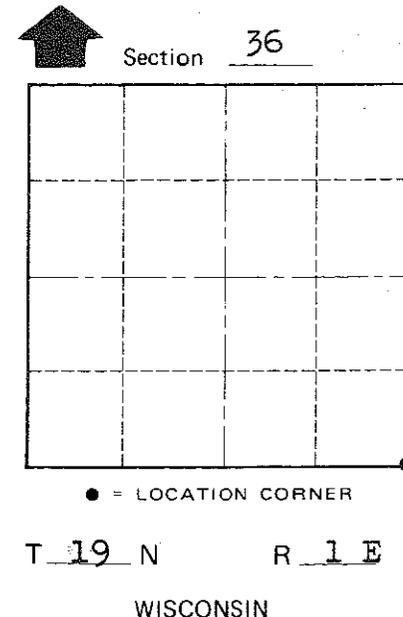

COUNTY SURVEYOR FORM NO. 1

Approved: **HARLEY A. SIME**  
**MONROE CO. SURVEYOR**

SURVEY CONTROL ORDER

Horizontal	_____
Vertical	_____

WISCONSIN COORDINATE SYSTEM

Corner	East (X)	North (Y)	Elevation (Z)	Zone
Control Sta. Name				

City, Village or Town Scott  
County of Monroe