


JACKSON COUNTY - U.S. PUBLIC LAND SURVEY MONUMENT RECORD

TYPE OF MONUMENT: 2-3/8" O.D. Iron Pipe w/ Threaded Iron Cap
 REFERENCED FOR SURVEY RECORDED IN CSM# _____ OR CSR# _____
 SURVEYOR'S FILE# OR PROJECT# Fieldbook: T20N-R1E, Pg. 24 - 25
 DRAWN BY: Ethan Remus
 WITNESS: Ethan Remus

CORNER VOL. 11, PAGE 1805
 CORNER# 42001330020
 SECTION 33, T 20 N, R 1E # 8
 S1/4 CORNER

GEOGRAPHIC LOCATION: NAD 83 (91) WISCRS- Jackson County
 COUNTY COORDINATE SYSTEM
 (TO BE ASSIGNED BY COUNTY)
 LATT: 44°09'29.29170" N
 LONG: 90°22'58.66610" W
 N = 47654.1140
 E = 209660.7209

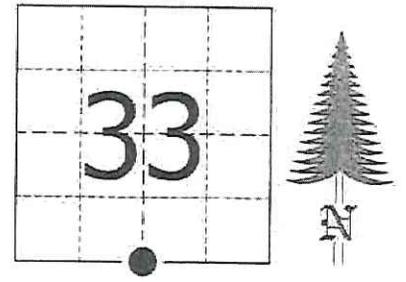

LOCATION
(INDICATE W/ MONUMENT SYMBOL)

BASIS FOR MONUMENT LOCATION:

Please describe if this is a found, obliterated or lost corner. Give a complete history of the corner listing the vol. & page, dates, surveyor and description of found monument. Please list all parole testimony and who provided it as well as other witness' of recovery. Please describe the best way to reach this corner. Indicate how obstructed this monument might be for GPS observations. Continue on backside if necessary.

* George Stuntz and James Sargent set a post for the quarter corner as part of the original Township Line survey in 1851. They referenced two bearing trees, a 12" Aspen N78°E - 23.10', and a 7" Aspen S40°E - 15.18'.

* S.L. Kennedy likely reestablished this corner in 1937 and set a standard pipe, but I found no note of it. In Kennedy's Fieldbook No. 25 on Pg. 44 he notes an "iron pipe or shaft" for the quarter corner at 39.98 chains East of the SW Corner of Section 33. It sounds like he found an iron here, but I do not know where it would have come from.

* Bill Jung visited this corner in 1982. He found a 3" capped iron pipe from Kennedy, up 32". He referenced it to four bearing trees. (See previous tie sheet)


* Larry Fedderson used this corner in 1991 and called for a 3" iron pipe up 32". (CSM No. 1440)

* In November of 2015, I found Kennedy's standard pipe (2-3/8" O.D. iron pipe w/ threaded on iron cap) up 25" above ground and perfectly plumb with a Monroe Co. witness sign 1' North and a carsonite DNR boundary marker 1' West. I found steel T-Posts apparently on line North and West from corner along with a brushed and flagged line East. I found Jung's bearing trees as depicted below. I found another 2-3/8" O.D. iron pipe in a mound of earth with pits plain N-S about 26.5' Nly from the Kennedy pipe. This pipe really threw me for a loop (no record of it). I poured over Kennedy's notes, and I got the impression that he had found a pipe at this corner. So I began to think maybe the Kennedy pipe was a witness. I talked with Tim Jeatran (Jackson County Surveyor). Tim worked with Larry Fedderson in the 90's and he remembered being at this corner with Larry. Larry thought he had found evidence of the original wood post and he set a pipe in that spot. He discussed this with the County Surveyor's from Jackson and Monroe Co's. They decided to hold the Kennedy pipe because Fedderson's location would have put a significant bend in the County Line. They thought Fedderson must have found an old fence post. I accepted Kennedy's pipe as the quarter corner and drove a steel witness sign post 1' South. I drove three rebar for references and tied in Fedderson's pipe to the corner. I could not observe this corner with GPS due to canopy. I set GPS control in the clearcut to the NW and turned in. I accessed this corner with a truck by driving a trail East from the end of Curtis Stall Rd.

CERTIFIED CORRECT AND COMPLETE
 TO THE BEST OF MY KNOWLEDGE
 AND BELIEF:
Ethan Remus
 Professional Land Surveyor
 DATE: March 14, 2016

TIE SKETCH

- = Found 2-3/8" O.D. Iron Pipe w/ Threaded Iron Cap.
- ⊗ = Found 2-3/8" O.D. Iron Pipe in Mound, Pits N-S.
- = Set 3/4" x 30" Rebar w/ ID Plug.
- ⊕ = Set 7' Steel Witness Sign Post.
- ⊖ = Found Monroe Co. Steel Witness Sign Post.
- ⇒ = Found Carsonite DNR Marker.

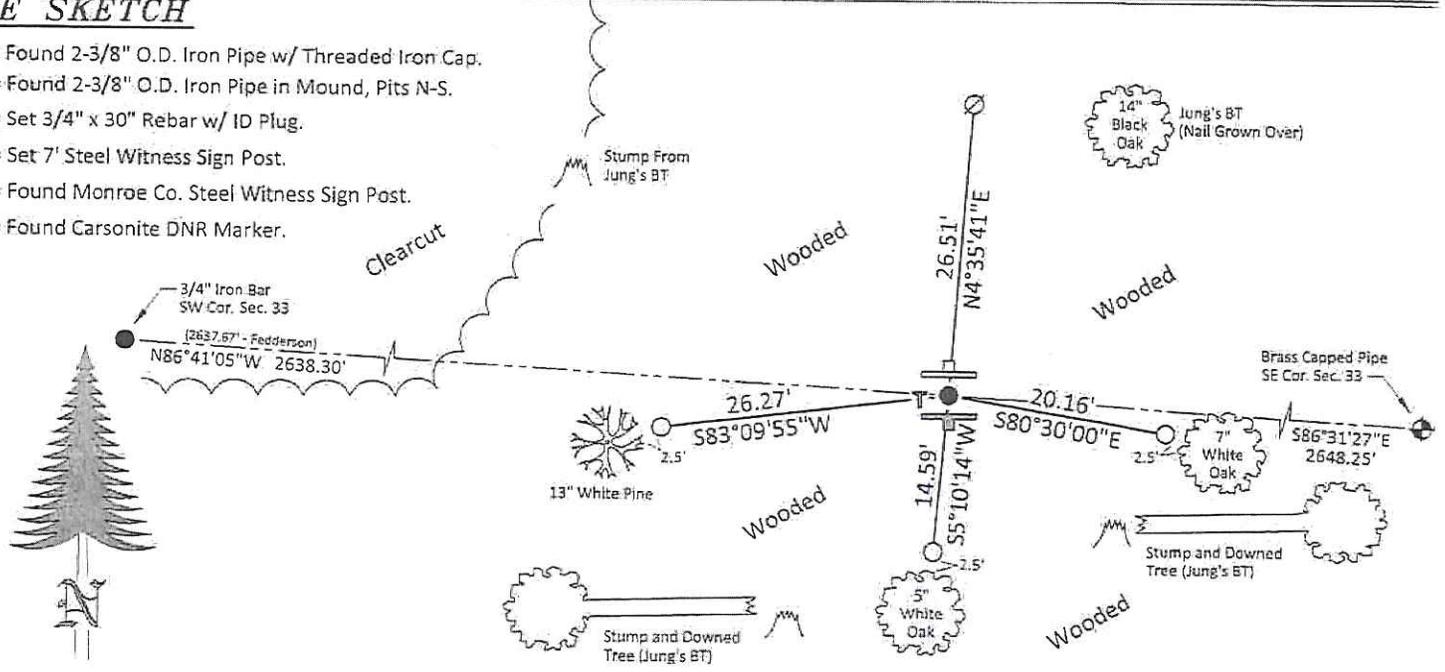

NOT TO SCALE

42001330020

I, William C. Jung, do hereby certify that on the 13th day of December 1982, I found (evidence) ~~no evidence~~ of the North 1/4 corner of Section 4, T19 N, R 1 E Fourth Principal Meridian, and I re-established said corner according to the Wisconsin Statutes as shown and described hereon.

History of corner establishment since Original Government Survey

Kennedy probably set a pipe at this corner in about 1937.

Description of corner evidence found:

I found and accepted a capped pipe which I believe was set by Kennedy.

Dated this 17th day of Dec. 1982.


William C. Jung
Deputy County Surveyor
Title

Approved: HARLEY A. SIME
MONROE CO. SURVEYOR

Description of corner and witness monuments, references and accessories used to perpetuate the original or re-established location of this corner:

Witnesses to corner location:


William C. Jung
Melvin A. Pliner

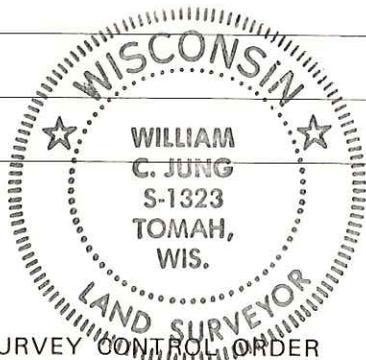



SURVEY CONTROL ORDER

Horizontal _____
Vertical _____

(Distances to top of pipe!)

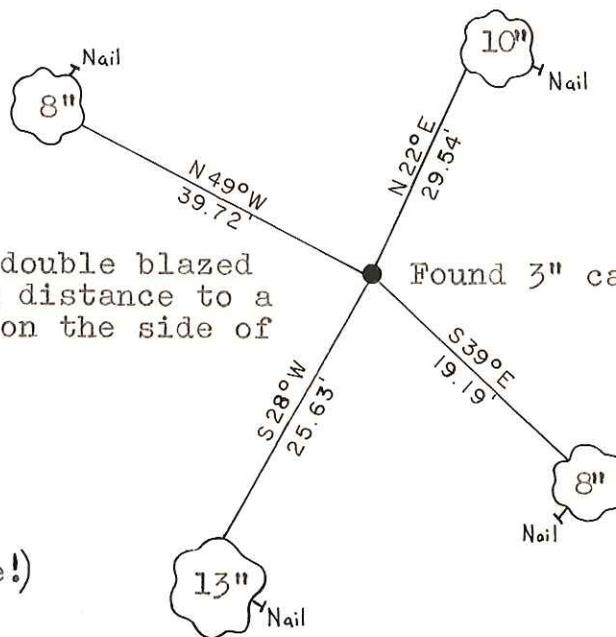

All B.T.'s are double blazed Oaks, with each distance to a nail in a hack on the side of the tree.

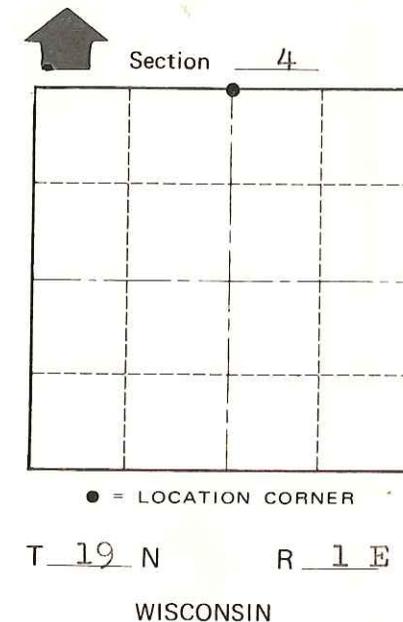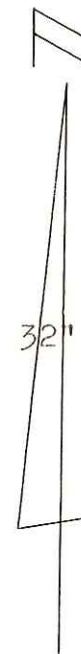

WISCONSIN COORDINATE SYSTEM

Corner	East (X)	North (Y)	Elevation (Z)	Zone
Control Sta. Name				

~~City, Village or~~ Town of Scott
County of Monroe

COUNTY SURVEYOR FORM NO. 1