

CERTIFICATE

CERTIFIED LAND CORNER

No. 65

Ps. 2

21601150000

I, Garold A. Sime, do hereby certify that on the 13th day of June 19 86, I found (evidence) ~~(no evidence)~~ of the NE corner of Sec. 22, T 16 N, R 1W Fourth Principal Meridian, and I re-established said corner according to the Wisconsin Statutes as shown and described hereon.

Dated this 29th day of Dec 19 86.

Garold A. Sime

Deputy County Surveyor
Title

History of corner establishment since Original Government Survey

* See previous land corner record

Description of corner evidence found:

I monumented this corner at location computed from the Dept. of Transportation right-of-way plat of S.T.H. "131" and previous survey information. This fits the remaining D.O.T. Tie reasonably well.

COUNTY SURVEYOR FORM NO. 1

Description of corner and witness monuments, references and accessories used to perpetuate the original or re-established location of this corner:


Set 1/4" round iron bar at corner

Witnesses to corner location:



Garold A. Sime, R.L.S.

Dallas Wilhite

Joel Tralmer

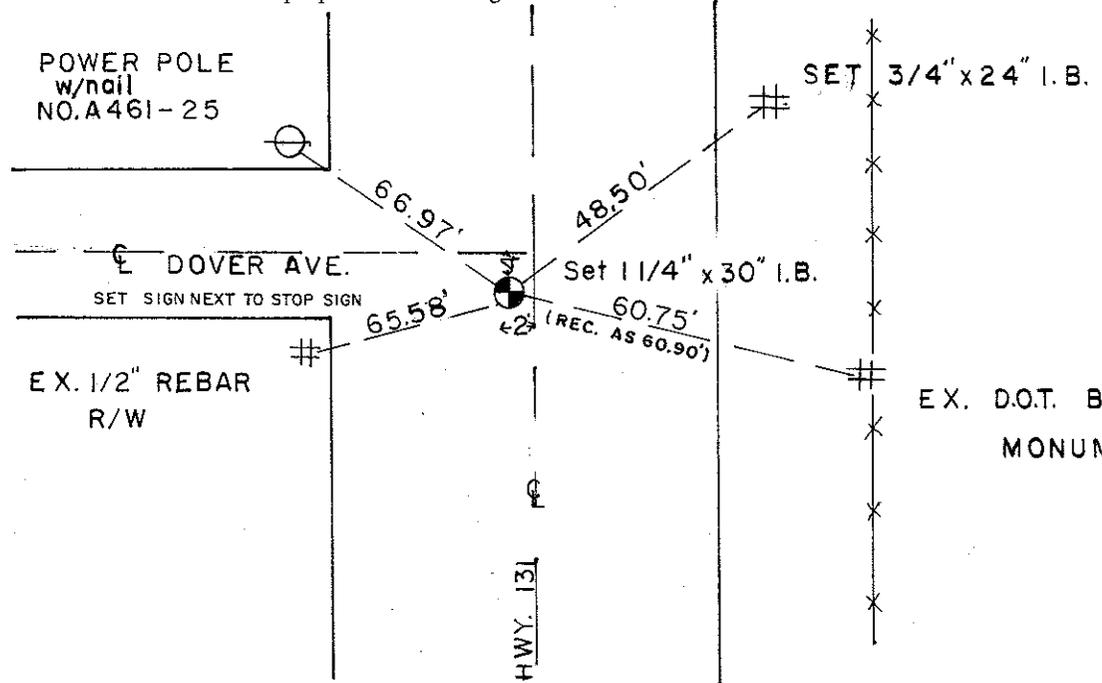

EX. D.O.T. BERNSTEN MONUMENT

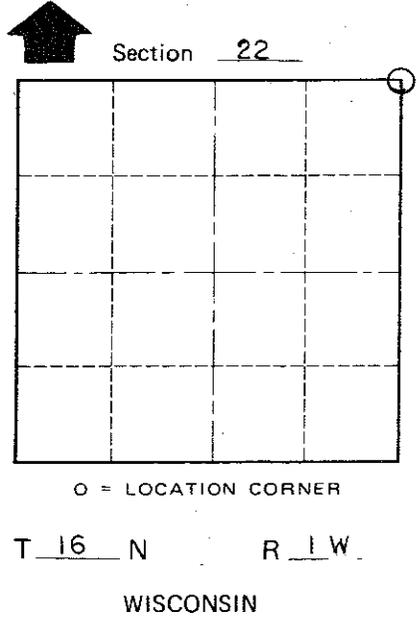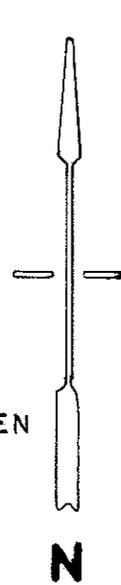

SURVEY CONTROL ORDER


Horizontal	_____
Vertical	_____

WISCONSIN COORDINATE SYSTEM


Corner	East (X)	North (Y)	Elevation (Z)	Zone
Control Sta. Name				

City, Village or Town Wilton
County of Monroe

COUNTY MONROE		
TOWN WILTON		
HIGHWAY S.T.H. 131		
SECTION 14	TOWNSHIP 16 N	RANGE 1 W
TYPE OF LANDMARK 1/4" X 30" IRON BAR IN PLACE SET BY MONROE CO. SURVEYOR 1977		

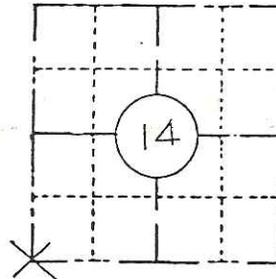

LOCATION SKETCH
(Location of landmark indicated by "x")

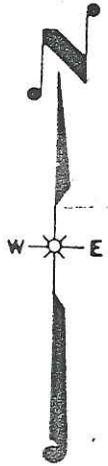


This space for copy of field notes or ties to the above described landmarks

- = 1/4" X 30" IRON BAR
- △ = WIS. D.O.T. BERNSTEIN MONU.
SET ALONG NEW S.T.H. 131 R/W

POWER POLE □

☒ DOVER AVE.

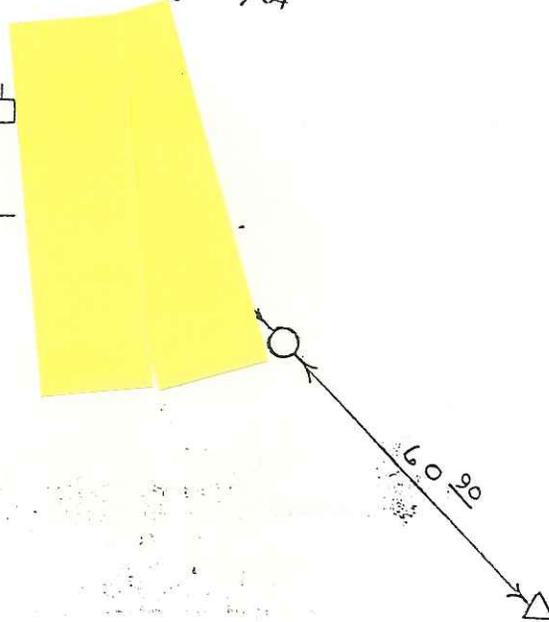

CREW CHIEF M. WEGE

FILED UNDER PROJECT NUMBER 5130-5-72		COUNTY CLERK'S OFFICE COUNTY OF WISCONSIN } 55	
SHC DISTRICT OFFICE NUMBER # 5	CITY LACROSSE	COUNTY LACROSSE	DATE RECEIVED FOR RECORD
LOCATED OR ESTABLISHED BY PERPETUATED NAME SURVEY COORDINATOR		DATE COPY SENT TO COUNTY SURVEYOR	
TITLE SURVEY COORDINATOR DATE 5-14-84		SIGNATURE OF COUNTY CLERK	

I, William C. Jung, do hereby certify that on the 28th day of October 19 77, I found ~~(evidence)~~ (no evidence) of the S.W. corner of Section 14, T 16 N, R 1 W, Fourth Principal Meridian, and I re-established said corner according to the Wisconsin Statutes as shown and described hereon.

Dated this 3rd day of Nov. 19 77.

William C. Jung, R.L.S. 1323
Crew Chief, County Surveyor's
 Title Office

History of original corner establishment:

Hamilton LaRue was at this corner in January of 1897 as was O.R. Dahl in June of 1869.

Description of corner evidence found:





Doubled the distance from the West 1/4 corner of Section 14 to the 1/8 corner to the South, and set this point at a location in proportion to the original government notes along the South line of the SW1/4 of Section 14 and along the South line of the SE1/4 of Section 15. This location fits very well the evidence found in Sections 14 and 15, and previous surveys.

Description of corner and witness monuments, references and accessories used to perpetuate the original or re-established location of this corner:
 Set a 1/4"x30" iron bar, down 1", and 5.5 ft. South of the centerline of Dover Ave.

Witnesses to corner location:

W. C. Jung

G. Dechant

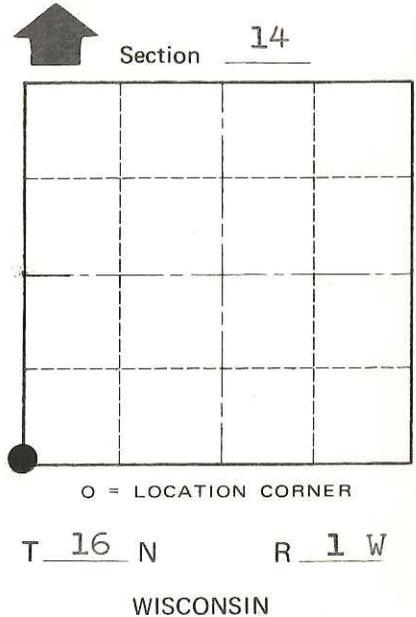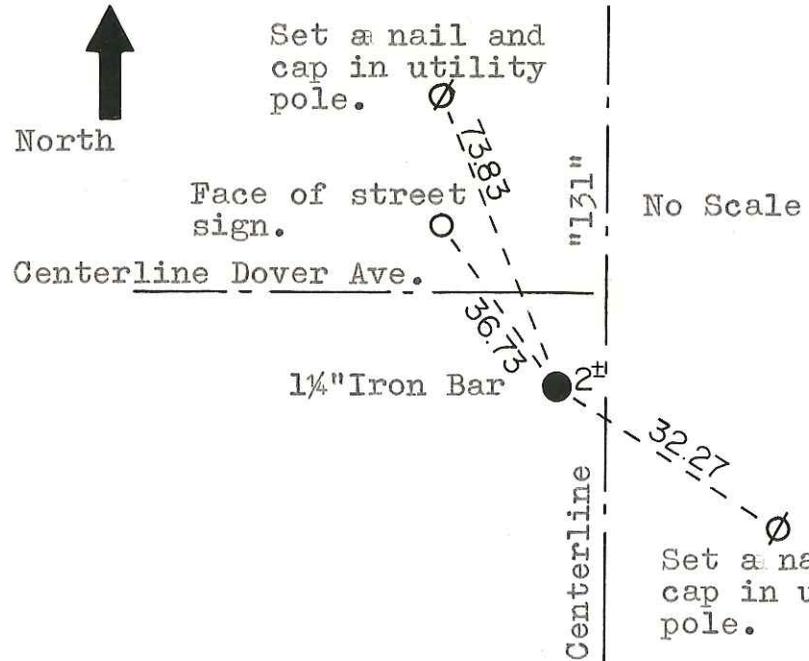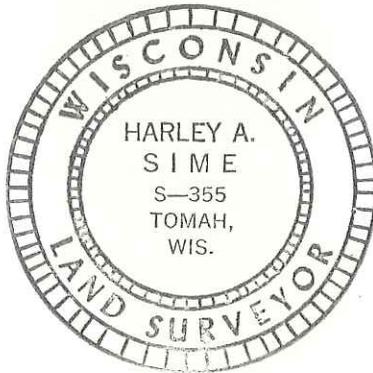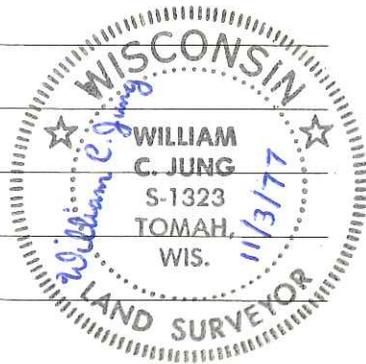

COUNTY SURVEYOR FORM NO. 1

SURVEY CONTROL ORDER

Horizontal	_____
Vertical	<u>Scaled Elev.</u>

Approved: Harley Sime
 County Surveyor

WISCONSIN COORDINATE SYSTEM

Corner	East (X)	North (Y)	Elevation (Z)	Zone
	<u>1875080.057</u>	<u>677044.773</u>	<u>1084+</u>	<u>SOUTH</u>
Control Sta. Name				

City, Village or Town Wilton
 County of Monroe