

CERTIFICATE

CERTIFIED LAND CORNER

No. 78

Pg. 2

21601222000

I, Garold A. Sime, do hereby certify that on the 13th day of June 19 86, I found ~~evidence~~ (no evidence) of the E¹/₄ corner of Sec. 22, T16 N, R 1W Fourth Principal Meridian, and I re-established said corner according to the Wisconsin Statutes as shown and described hereon.

Dated this 29th day of Dec 19 86.

Garold A. Sime

Deputy County Surveyor

Title

History of corner establishment since Original Government Survey

*See previous land corner record

Description of corner evidence found:

Set this corner at a previously computed location after traversing between known points.

COUNTY SURVEYOR FORM NO. 1

Description of corner and witness monuments, references and accessories used to perpetuate the original or re-established location of this corner:


Set 1 1/4" round iron bar at corner

Witnesses to corner location:

Garold A. Sime, R.L.S.

Dallas Wilhite

Joel Tralmer

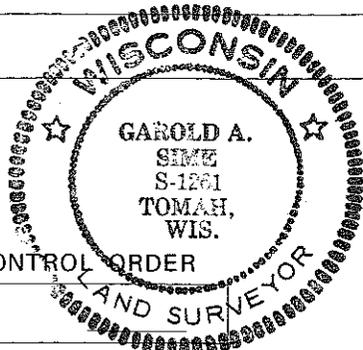

SET 3/4" x 24" I.B.



S.T.H. HWY. 131

44.59'

SET 3/4" x 24" I.B.



SIGN SET NEXT TO BAR

32.68'

5'

SET 1 1/4" x 30" I.B.


49.46'

SET 3/4" x 24" I.B.



POWER POLE w/nail

66.23'

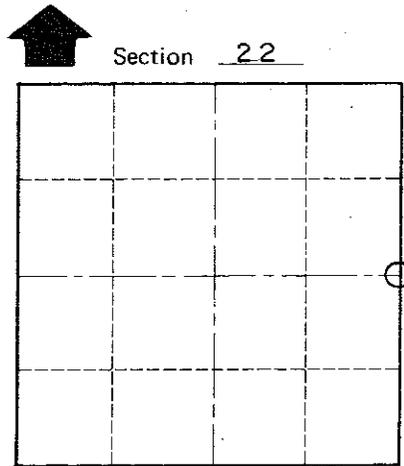

O = LOCATION CORNER

T 16 N R 1W

WISCONSIN


WISCONSIN COORDINATE SYSTEM

Horizontal	Vertical	East (X)	North (Y)	Elevation (Z)	Zone
Corner					
Control Sta. Name					


City, Village or Town Wilton

County of Monroe

COUNTY MONROE		
TOWN WILTON		
HIGHWAY S.T.H. 131		
SECTION 23	TOWNSHIP 16 N	RANGE 1 W
TYPE OF LANDMARK 1/4" IRON BAR IN PLACE SET BY MONROE CO. SURVEYOR 1977		

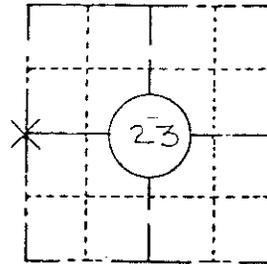


LOCATION SKETCH
(Location of landmark indicated by "x")

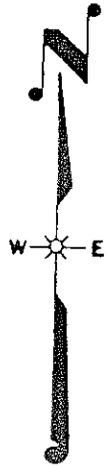

This space for copy of field notes or ties to the above described landmarks

- = 1/4" IRON BAR 30" LONG
- = 3/4" IRON BAR 24" LONG
- △ = WIS. D.O.T. BERNSTEIN MONU.
SET ALONG NEW S.T.H. 131 R/W.

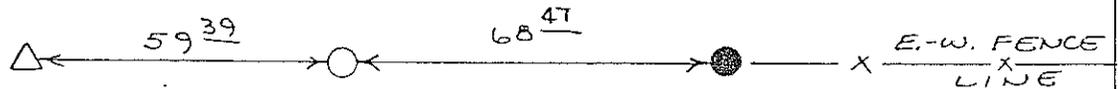

CREW CHIEF M. WEGE.

FILED UNDER PROJECT NUMBER 5130-5-72			COUNTY CLERK'S OFFICE			
SHC DISTRICT OFFICE NUMBER # 5		CITY LACROSSE	COUNTY LACROSSE	COUNTY OF WISCONSIN } 55	DATE RECEIVED FOR RECORD	DATE COPY SENT TO COUNTY SURVEYOR
LOCATED OR ESTABLISHED BY NAME DERALD E. KADING			SIGNATURE OF COUNTY CLERK			
TITLE SURVEY COORDINATOR DATE 5-14-84						

CERTIFICATE

CERTIFIED LAND CORNER

No. 78

Pg. 1

I, William C. Jung, do hereby certify that on the 28th day of October 1977, I found (evidence) (~~no evidence~~) of the West 1/4 corner of Section 23, T 16 N, R 1 W, Fourth Principal Meridian, and I re-established said corner according to the Wisconsin Statutes as shown and described hereon.

History of original corner establishment:

No recorded history since the original government survey.

Description of corner evidence found:

This corner caused no small amount of concern to this surveyor. I set the corner on line with the section corners North and South, and on line with with an old fence to the East and with evidence of an old established line going West to the occupied Center 1/4 of Section 22. The result of this is that the distance North to the N.W. corner of Section 23 is (1) chain plus long, but the corner as set fits the greater bulk of field evidence found along the two miles measured between 15/22 14/23 and 27/34 26/35.

Dated this 3rd day of Nov. 1977.

William C. Jung, R.L.S. 1323



Crew Chief, County Surveyor's
Title Office

Description of corner and witness monuments, references and accessories used to perpetuate the original or re-established location of this corner:
Set a 1 1/4"x30" iron bar, down 1", 4 ft. East of the centerline of S.T.H. "131".



Witnesses to corner location:

W. C. Jung

G. Dechant

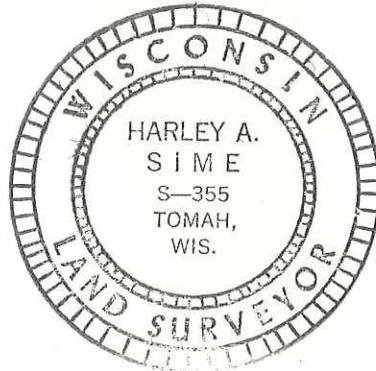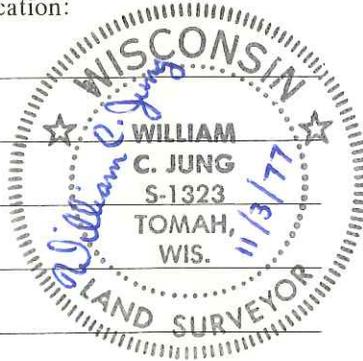

Set nail & cap in pole.

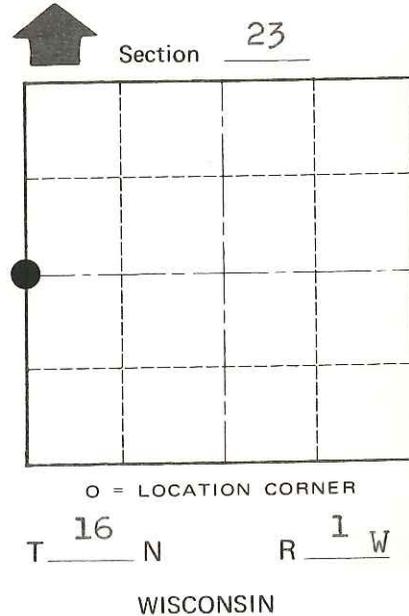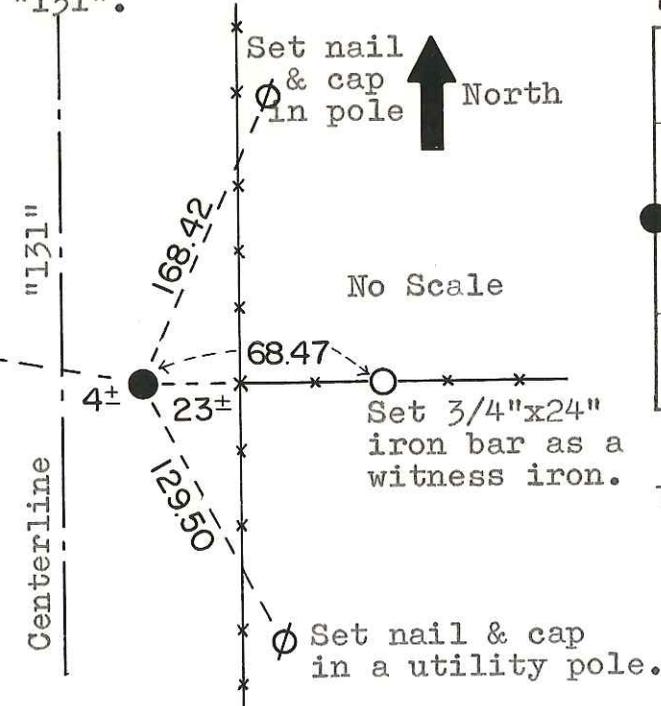

COUNTY SURVEYOR FORM NO. 1

SURVEY CONTROL ORDER

Horizontal _____

Vertical Scaled Elev.

Approved: Harley Sime
County Surveyor

WISCONSIN COORDINATE SYSTEM

Corner	East (X)	North (Y)	Elevation (Z)	Zone
	<u>1875045.137</u>	<u>674338.635</u>	<u>1050±</u>	<u>SOUTH</u>
Control Sta. Name				

City, Village or Town Wilton

County of Monroe