

Government Land Corner Certificate

Jackson County

CORNER VOL. 8, PAGE 1242

CORNER # 21905160000

SECTION 21, T 19, N, R 5W

TYPE OF MONUMENT: Harrison Cast Iron Monument

~~STAKE PLAIN~~ COORDINATES: N 31438.8178 WISCRS NAD83(91)

E 54646.8637 Ethan D. Remus


ELEVATION - M.S.L. DATUM: _____ 12/28/2015

THETA ANGLE: _____

FIELD BOOK: HSE File 88N-005 PAGE _____

DRAWN BY: D.W. Melichar

REFERENCED FOR SURVEY RECORDED IN: Monroe County

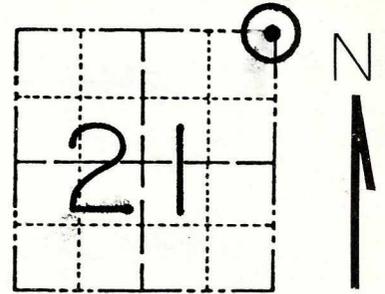

BASIS FOR MONUMENT LOCATION

Show info such as: History of corner, with reference to Vol. and pg., dates, surveyor; exact description of monument replaced; if location computed, by taped or EDM traverse; landowner remarks, etc. (Use reverse side if necessary)

C.M. Keach, in CSR 830, Vol. 3, P. 65, dated 1914, found a stake trace, one bearing tree down, and a trace of the other bearing tree. He set an iron stake at the corner. We found a 3/4-inch pipe, broken about 8 inches down, but plumb below that. We accepted this as CMK's iron stake, and replaced it with a Harrison Cast Iron Monument.

LOCATION
(Shown by monument symbol)

SEAL:



DATA SHOWN HERE ON
CERTIFIED CORRECT:



Norman R. Hurlburt

Registered Land Surveyor

DATE: 6/16/88

TIE SKETCH

Show at least four ties, also fence lines, roads, topo, size and type of witness trees' and if off road - best way to arrive at corner.

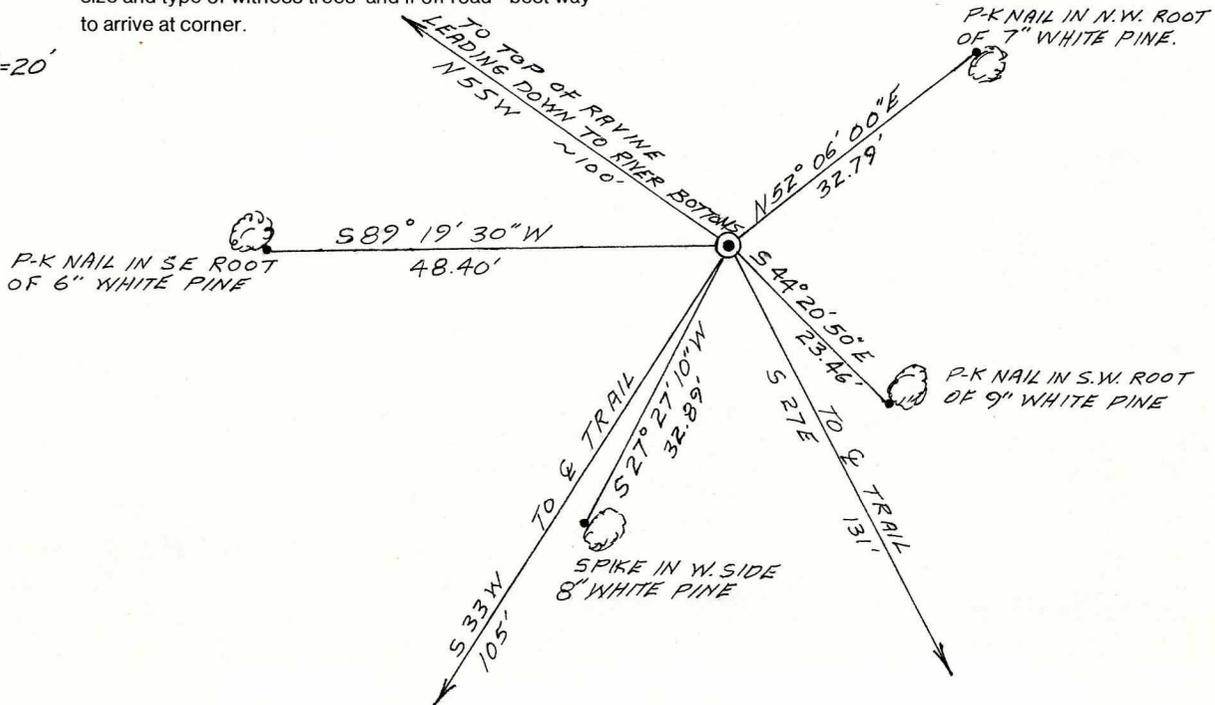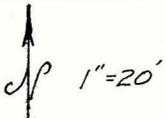

CERTIFICATE

CERTIFIED LAND CORNER

No. 67

21905160000

I, Norman R. Hurlburt, do hereby certify that on the 24 day of February 1988, I found ~~(evidence) (no evidence)~~ of the NW corner of Sec. 22, T 19 N, R 5 W Fourth Principal Meridian, and I re-established said corner according to the Wisconsin Statutes as shown and described hereon.

Dated this 16 day of JUNE 1988.

Norman R. Hurlburt

S-1104

Title

History of corner establishment since Original Government Survey

C.M. Keach, in Jackson County Survey Record No. 830, Vol. 3, P. 65, dated 1914, found a stake trace, one bearing tree down, and a trace of other bearing tree. He set an iron stake at the corner.

Description of corner evidence found:

We found a 3/4-inch pipe, broken about 8 inches down, but plumb below that. We accepted this as CMK's iron stake, and replaced it with a Harrison Cast Iron Monument.



Description of corner and witness monuments, references and accessories used to perpetuate the original or re-established location of this corner:

Witnesses to corner location:

D.W. Melichar

R. Found

N.R. Hurlburt

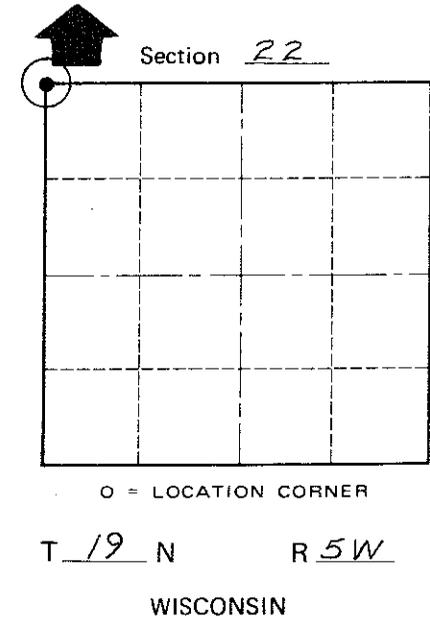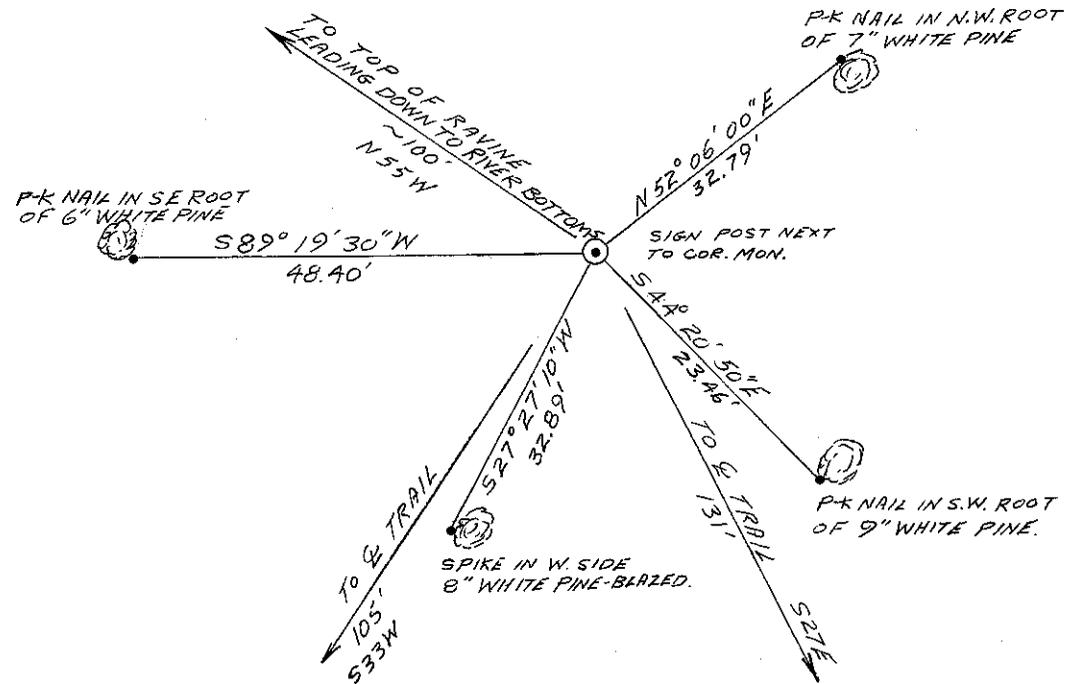

COUNTY SURVEYOR FORM NO. 1

SURVEY CONTROL ORDER

Horizontal	_____
Vertical	_____

WISCONSIN COORDINATE SYSTEM

Corner	East (X)	North (Y)	Elevation (Z)	Zone
Control Sta. Name				

City, Village or Town LITTLE FALLS

County of MONROE