


JACKSON COUNTY - U.S. PUBLIC LAND SURVEY MONUMENT RECORD

TYPE OF MONUMENT BRASS CAPPED IRON PIPE
 REFERENCED FOR SURVEY RECORDED IN CSM# _____ OR CSR# _____
 SURVEYOR'S FILE# OF PROJECT# _____
 DRAWN BY: Tim Jeatran
 WITNESS: Ralph Eswein & Tim Jeatran

CORNER VOL. 13, PAGE 2057
 CORNER# 22003350020
 SECTION 35, T 20 N, R 03W
 S1/4 CORNER

GEOGRAPHIC LOCATION: NAD 83 (91) WISCRS- Jackson County
 COUNTY COORDINATE SYSTEM
 (TO BE ASSIGNED BY COUNTY)
 LATT: 44°09'33.29183"N
 LONG: 90°42'09.33719"W
 ELLIPSOID HEIGHT _____ m _____ ft. N = 47751.7270
 ORTHO HEIGHT _____ m _____ ft. E = 125772.0701
 Estimated height accuracy ± _____

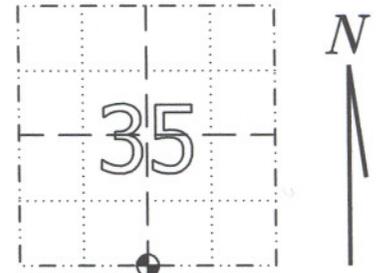


LOCATION
 (INDICATE W/ MONUMENT SYMBOL)

BASIS FOR MONUMENT LOCATION

Please describe if this is a found, obliterated or lost corner. Give a complete history of the corner listing the vol. & page, dates, surveyor and description of found monument. Please list all parole testimony and who provided it as well as other witness' of recovery. Please describe the best way to reach this corner. Indicate how obstructed this monument might be for GPS observations. Continue on backside if necessary.

C.M. Keach was at this corner in C.S.R. #122, dated June 1902 and states "Original gone, reestablished equidistant from section corners. Set stake."
 In Keith Bennett's resurvey of the township, dated 1939, he set a brass capped iron pipe and oak post in mound in N-S fence line with pits E-W.
 W.C. Jung was at this corner in December 1982 and found Keith Bennett's brass capped iron pipe. He redug the old pit 4.5 feet West and mounded the pipe. He also set nails in four trees as references and filed a land corner tie sheet in Monroe County. We found Keith Bennett's brass capped iron pipe stamped 1939, up 14" in a mound with pits East & West. We accepted his pipe as the corner and set a 7 foot witness sign post one foot North and referenced as shown below.
 GPS observations may be difficult due to the tree cover. This corner was accessed by a logging from Habelman Road Southeast of the corner.

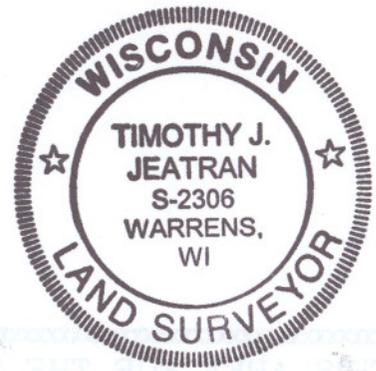

CERTIFIED CORRECT AND COMPLETE
 TO THE BEST OF MY KNOWLEDGE
 AND BELIEF:

Timothy J. Jeatran
 Registered Land Surveyor


DATE: June 12, 2008

TIE SKETCH

Show at least four ties. Show fence lines-roads-topo features-size and type of witness trees-trails if available.



○ = SET 3/4" X 24" REBAR.

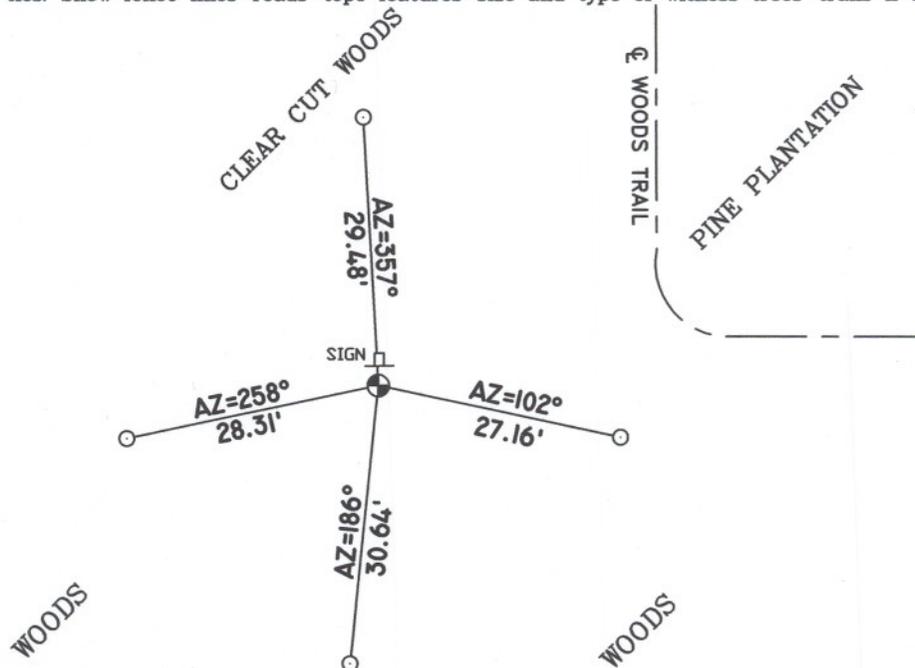

22003350020

I, William C. Jung, do hereby certify that on the 2nd day of October 1982, I found (evidence) ~~no evidence~~ of the North 1/4 corner of Section 2, T19 N, R3 W Fourth Principal Meridian, and I re-established said corner according to the Wisconsin Statutes as shown and described hereon.

History of corner establishment since Original Government Survey
In 1939 Keith Bennett set an iron pipe at the corner.

Description of corner evidence found:

I found Bennett's pipe at the corner

Dated this 17th day of Dec. 1982.

William C. Jung

Deputy County Surveyor
Title

Approved: **HARLEY A. SIME**
MONROE CO. SURVEYOR



COUNTY SURVEYOR FORM NO. 1

Description of corner and witness monuments, references and accessories used to perpetuate the original or re-established location of this corner:


Fd. 2 1/4" pipe with a 2 3/4" brass cap, up 2'+. Redug old pit 4.5' to West and mounded pipe. All bearings are magnetic. All B.T.'s double blazed; each distance is to a nail in a hack on the tree. Fd. traces of old fence wire near pipe. Pipe was marked with the year "1939".
Witnesses to corner location:

William C. Jung

Bryan H. Meyer

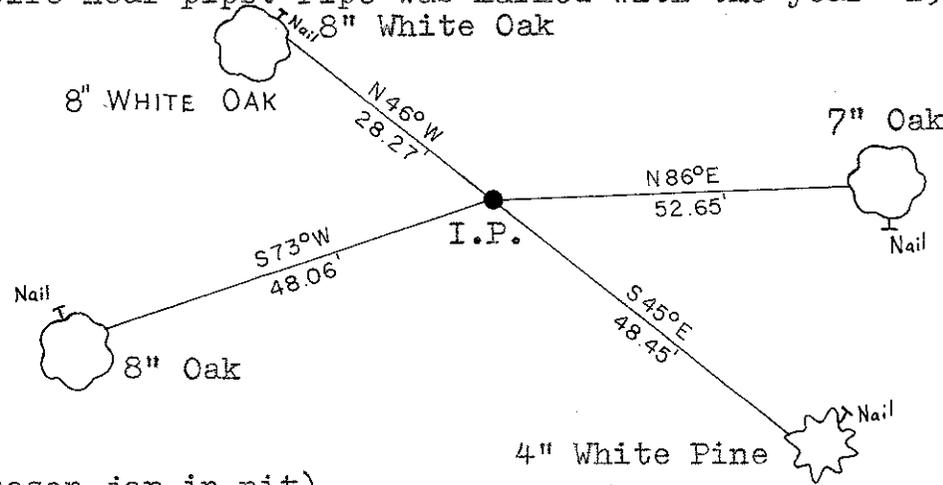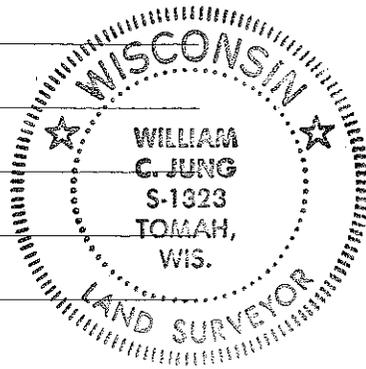

NOTE:
(Fd. mason jar in pit)

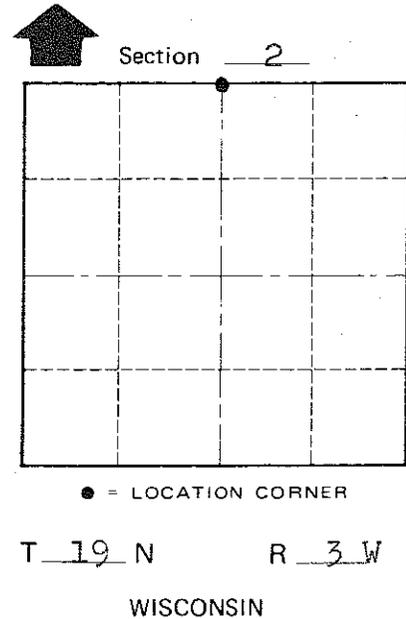

SURVEY CONTROL ORDER

Horizontal _____
Vertical _____

WISCONSIN COORDINATE SYSTEM

Corner	East (X)	North (Y)	Elevation (Z)	Zone
Control Sta. Name				

~~City, Village or~~ Town of New Lyme
County of Monroe