


2

JACKSON COUNTY - U.S. PUBLIC LAND SURVEY MONUMENT RECORD

TYPE OF MONUMENT: 2-3/8" O.D. Brass Capped Iron Pipe
 REFERENCED FOR SURVEY RECORDED IN CSM# _____ OR CSR# _____
 SURVEYOR'S FILE# OR PROJECT# Fieldbook: T20N-R3W, Pg. 4 - 5
 DRAWN BY: Ethan Remus
 WITNESS: Ethan Remus

CORNER VOL. 15, PAGE 2309
 CORNER# 22003360020
 SECTION 36, T 20 N, R 3W
 S1/4 CORNER

GEOGRAPHIC LOCATION: NAD 83 (91) WISCRS- Jackson County
 COUNTY COORDINATE SYSTEM
 (TO BE ASSIGNED BY COUNTY)
 LATT: 44°09'33.85823" N
 LONG: 90°40'56.85496" W
 N = 47818.7651
 E = 131056.0634

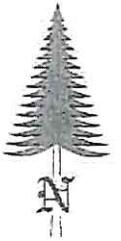

LOCATION
(INDICATE W/ MONUMENT SYMBOL)

BASIS FOR MONUMENT LOCATION:

Please describe if this is a found, obliterated or lost corner. Give a complete history of the corner listing the vol. & page, dates, surveyor and description of found monument. Please list all parole testimony and who provided it as well as other witness of recovery. Please describe the best way to reach this corner. Indicate how obstructed this monument might be for GPS observations. Continue on backside if necessary.

* James Freeman set a post for the quarter corner as part of the original Township Line survey in 1845. He referenced two bearing trees, a 10" Black Oak N19°W - 2.64', and a 7" Pine N54°E - 6.60'.

* Keith Bennett visited this corner in 1939 as part of his resurvey of T20N-R3W for the Jackson County Forest. He reestablished this corner by proportion and set an iron pipe with oak post in a mound of earth with pits E-W. He referenced two new bearing trees, a 2" Black Oak S30°E - 5.28' and a 5" Black Oak S57°W - 20.46'.

* Bill Jung visited this corner in 1982. He found Bennett's stamped cap pipe up 12" in a mound of earth along with his SW bearing tree. He accepted Bennett's pipe as the quarter corner, redug the West pit and referenced four new bearing trees. (See previous tie sheet)

* In December of 2015, I found Bennett's 2-3/8" O.D. brass capped iron pipe up 12" above a mound of earth with pits plain E-W. The pipe was leaning some to the West. The brass cap was stamped '1939' on the South side. I found rotten oak stump remains from Bennett's SW bearing tree along with Jung's four BT's, all still alive, as depicted below. I accepted Bennett's pipe as the quarter corner, plumbed it, and drove it down to resistance. I redug the East pit and used the dirt to build up the mound, leaving the pipe up 2". I drove a 7' steel witness sign post 1' South and drove four rebar for references as depicted below. I observed the corner directly with GPS after the leaves fell and there were many satellites available. Observations may be difficult otherwise. I accessed the corner by driving a logging trail SEly from Habelman Rd, through Jackson County Forest land. This trail takes you to about 800' North of the corner.



CERTIFIED CORRECT AND COMPLETE TO THE BEST OF MY KNOWLEDGE AND BELIEF:



Ethan Remus
Professional Land Surveyor

DATE: March 28, 2016

TIE SKETCH

- ⊕ = Found 2-3/8" O.D. Brass Capped Iron Pipe.
- = Set 3/4" x 30" Rebar w/ ID Plug.
- 🚧 = Set 7' Steel Witness Sign Post.

*Bearings are referenced to magnetic North.

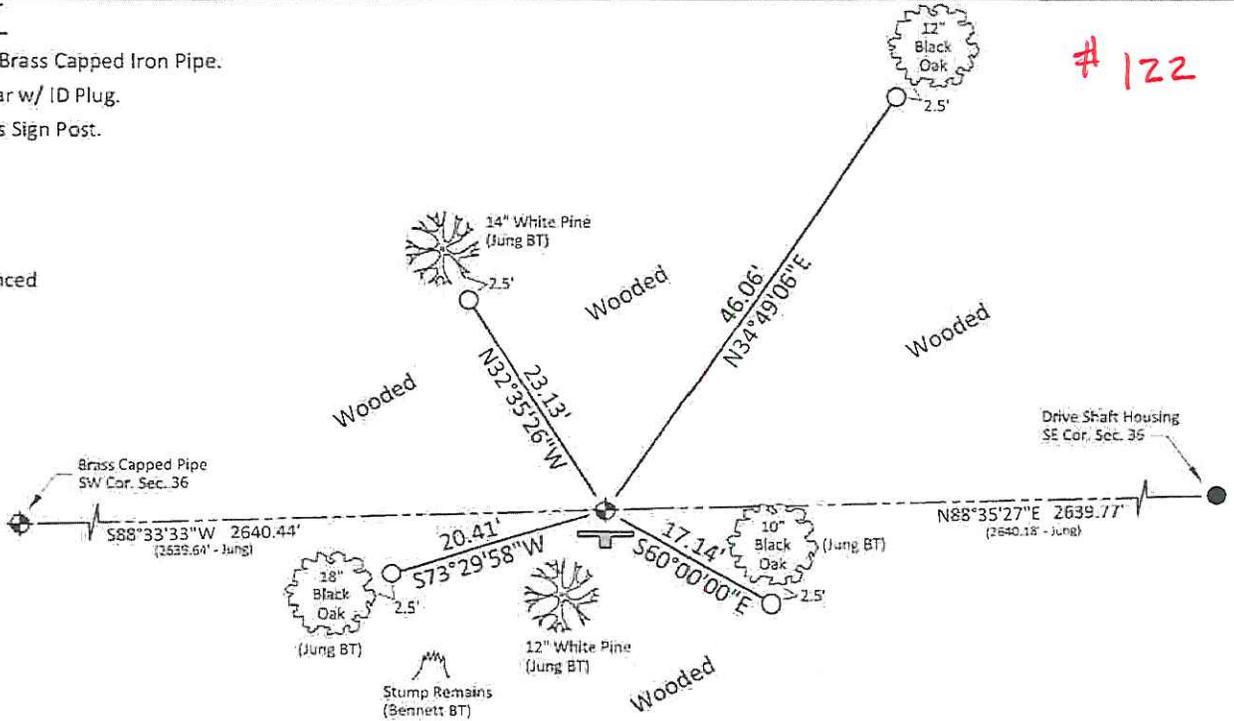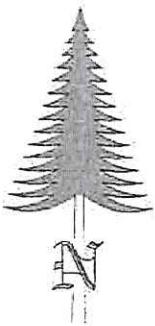

122

I, William C. Jung, do hereby certify that on the 14th day of December (1982), I found (evidence) ~~no evidence~~ of the North 1/4 corner of Section 1, T19 N, R3 W Fourth Principal Meridian, and I re-established said corner according to the Wisconsin Statutes as shown and described hereon.

Dated this 17th day of Dec. 1982.

William C. Jung
Deputy County Surveyor
Title

History of corner establishment since Original Government Survey

In about 1939 or 1940 Keith Bennett set an iron pipe at this corner.


Description of corner evidence found:

I found Bennett's pipe at the corner. I also measured S60°W, 20.75' to the center of a 7" oak. This tree is one of Bennett's old bearing trees.



Description of corner and witness monuments, references and accessories used to perpetuate the original or re-established location of this corner:

Witnesses to corner location:

William C. Jung

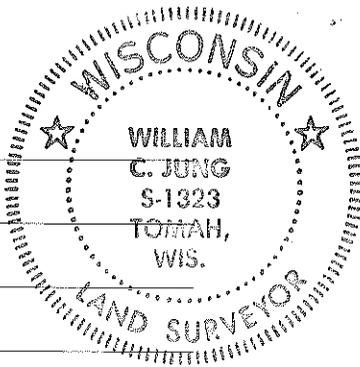

Approved: **HARLEY A. SIME**
MONROE CO. SURVEYOR

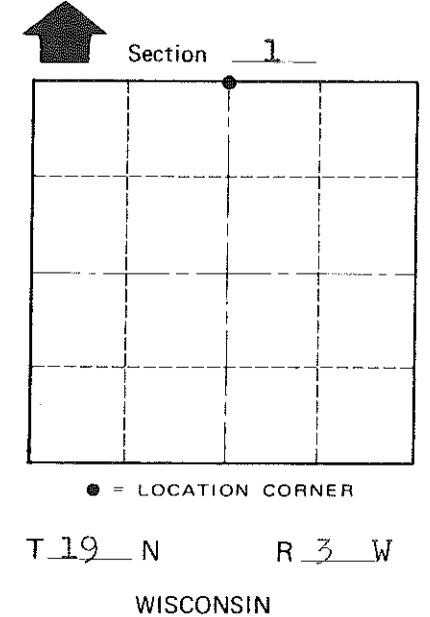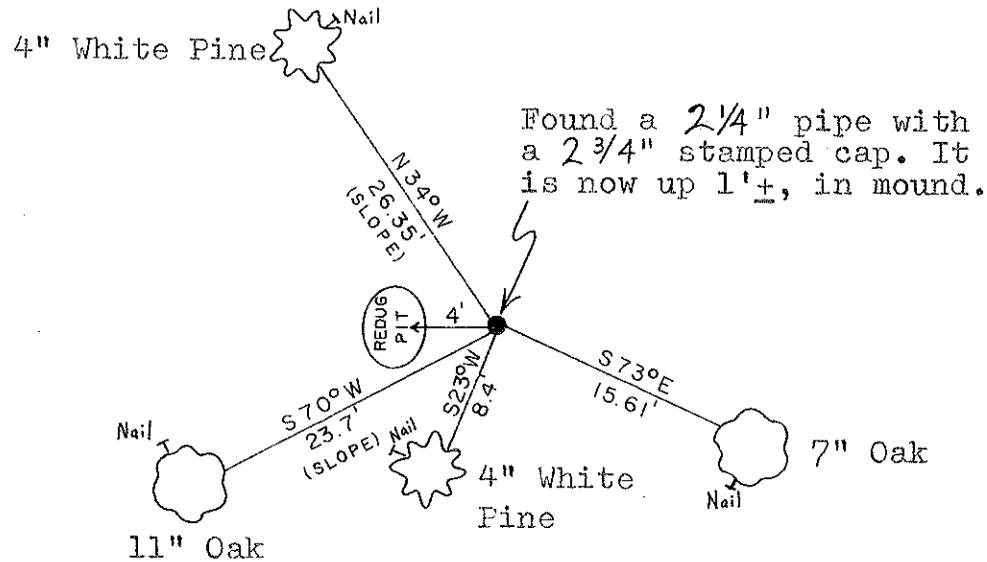

All B.T.'s double blazed; each dist. to a nail in a hack on the side of the tree.

WISCONSIN COORDINATE SYSTEM

| | |
|------------|-------|
| Horizontal | _____ |
| Vertical | _____ |

| Corner | East (X) | North (Y) | Elevation (Z) | Zone |
|-------------------|----------|-----------|---------------|------|
| Control Sta. Name | | | | |

~~City, Village or~~ Town of New Lyme
County of Monroe

COUNTY SURVEYOR FORM NO. 1