

CSR 2199


PROJECT- TOMAH #774326
 SURVEYED FOR:
 EDGE CONSULTING ENGINEERS, INC.
 624 WATER STREET
 PRAIRIE DU SAC, WI 53578

AND
 SURVEYED FOR:
 US CELLULAR
 8410 BRYN MAWR AVENUE
 CHICAGO, IL 60631

PROPERTY OWNER:
 US CELLULAR
 8410 BRYN MAWR AVENUE
 CHICAGO, IL 60631
 TOWER OWNER:
 US CELLULAR
 8410 BRYN MAWR AVENUE
 CHICAGO, IL 60631

PARCEL NO.: 014-00097-2000
 DEED: VOLUME 383, PAGE 593
 DOCUMENT NO. 507267

BEARINGS REFERENCED TO THE MONROE
 COUNTY COORDINATE SYSTEM AND THE WEST
 LINE OF THE NW1/4, SECTION 10, T.18N., R.2W.
 WHICH BEARS: N00-15-11"E

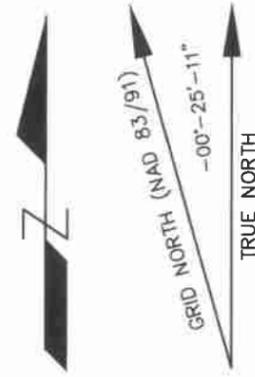


EXISTING TOWER BASE

LATITUDE: 44°-03'-16.93"
 LONGITUDE: 90°-36'-38.66"
 (Per North American Datum of 83/91)
 Top of Lightning Rod Elevation: 1590.9'
 (Highest Point)
 Top of Light Elevation: 1581.3'
 Top of Tower Elevation: 1578.8'
 Top of Antenna Elevation: 1577.5'
 Bottom of Antenna Elevation: 1569.2'
 Top of Antenna Elevation: 1576.8'
 Bottom of Antenna Elevation: 1570.9'
 Top of Dish Elevation: 1568.1'
 Bottom of Dish Elevation: 1560.3'
 Guy Wire Elevation: 1556.3'
 Centerline of Dish Elevation: 1542.3'
 Top of Dish Elevation: 1540.0'
 Bottom of Dish Elevation: 1534.3'
 Centerline of Dish Elevation: 1529.7'
 Top of Drum Elevation: 1525.8'
 Bottom of Drum Elevation: 1519.7'
 Top of Dish Elevation: 1497.8'
 Bottom of Dish Elevation: 1491.6'
 Top of Dish Elevation: 1496.8'
 Bottom of Dish Elevation: 1491.9'
 Guy Wire Elevation: 1478.0'
 Centerline of Dish Elevation: 1471.9'
 Ground Elevation: 1407.4'
 (Per National Geodetic Vertical Datum of 1929)

SURVEY NOTES:

- THE LOCATION OF THE EXISTING UTILITIES, AS SHOWN ON THIS PLAN, ARE APPROXIMATE ONLY. IT SHALL BE THE RESPONSIBILITY OF THE CONTRACTOR TO VERIFY ACTUAL LOCATION AND DEPTH OF ALL EXISTING UTILITIES. THE OWNER AND THE SURVEYOR SHALL NOT BE RESPONSIBLE FOR ANY OMISSION OR VARIATION FROM THE LOCATION SHOWN.
- NO TITLE SEARCH FOR PARCEL OWNERSHIP OR EXISTENCE OR NONEXISTENCE OF RECORDED OR UNRECORDED EASEMENTS HAS BEEN COMPLETED AS PART OF THIS SURVEY.
- THIS IS NOT A BOUNDARY SURVEY OF THE PARENT PARCEL. THIS SURVEY REPRESENTS THE LEASE AREA AND EASEMENTS ONLY.

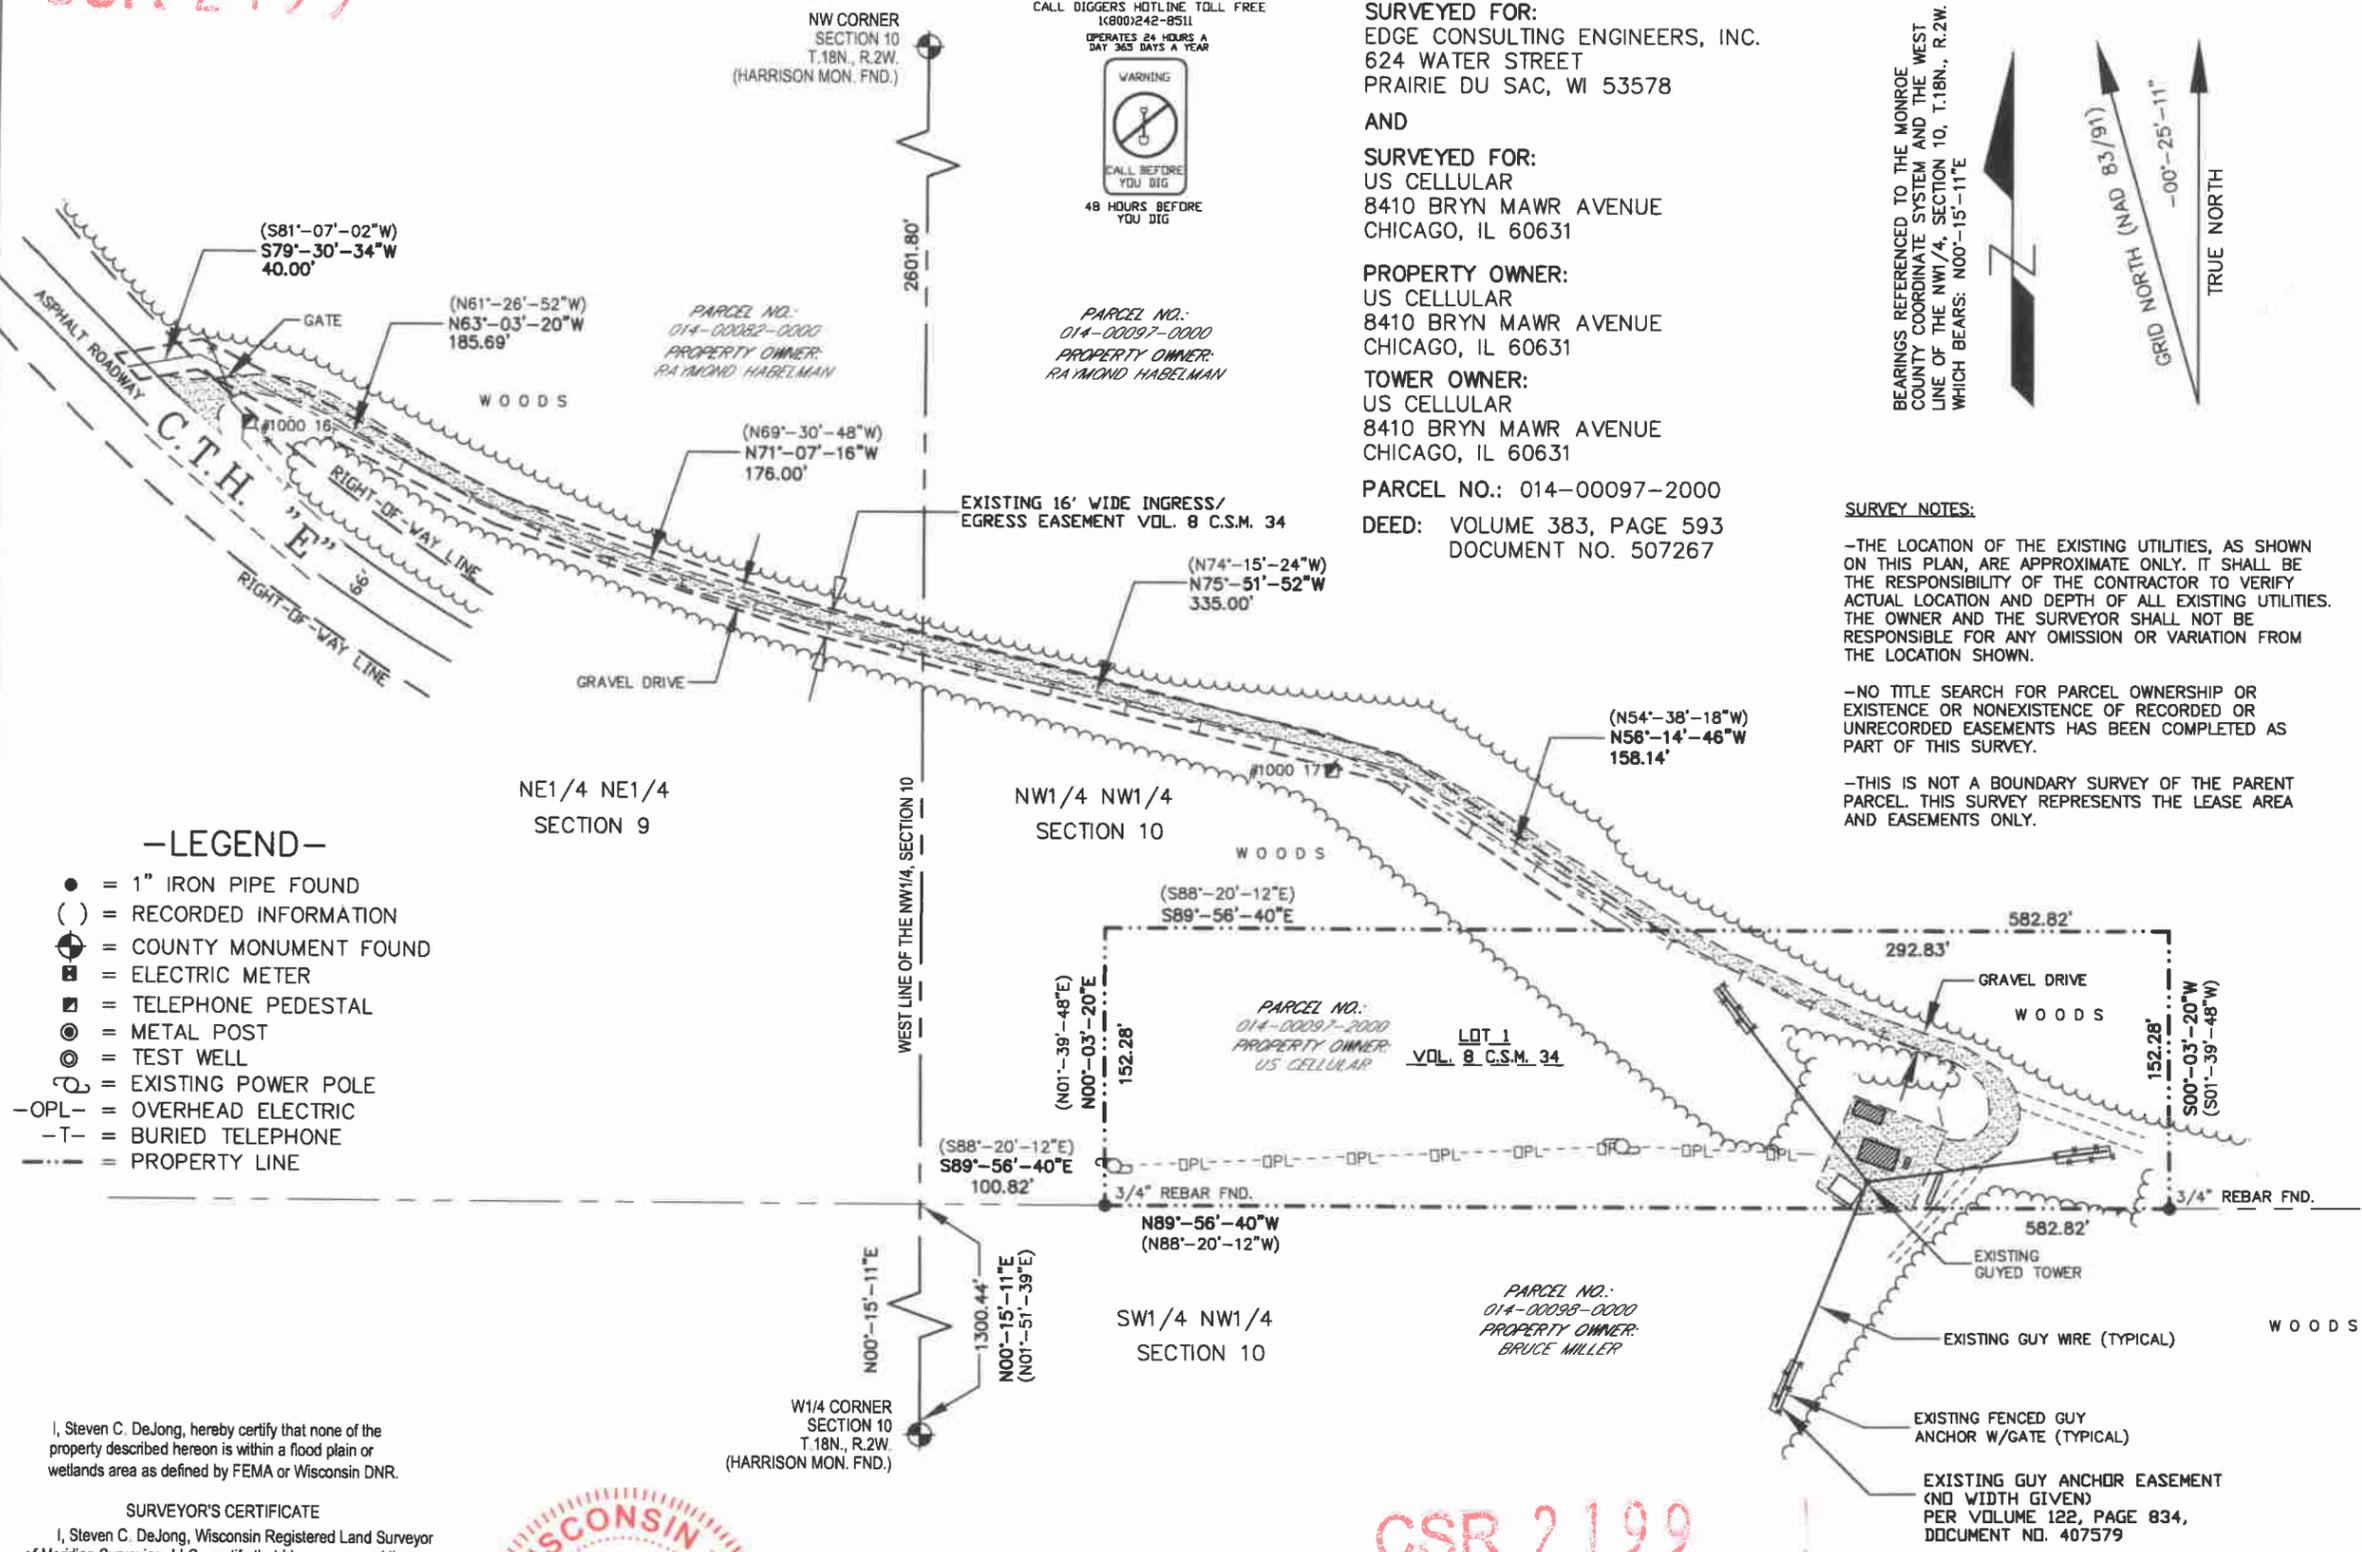


- LEGEND-**
- = 1" IRON PIPE FOUND
 - () = RECORDED INFORMATION
 - ⊕ = COUNTY MONUMENT FOUND
 - ⊠ = ELECTRIC METER
 - ⊡ = TELEPHONE PEDESTAL
 - ⊙ = METAL POST
 - ⊗ = TEST WELL
 - ⊕ = EXISTING POWER POLE
 - OPL- = OVERHEAD ELECTRIC
 - T- = BURIED TELEPHONE
 - = PROPERTY LINE

I, Steven C. DeJong, hereby certify that none of the property described hereon is within a flood plain or wetlands area as defined by FEMA or Wisconsin DNR.


SURVEYOR'S CERTIFICATE
 I, Steven C. DeJong, Wisconsin Registered Land Surveyor of Meridian Surveying, LLC., certify that I have surveyed the described property and that the map shown is a true and accurate representation thereof to the best of my knowledge and belief.

Dated this 26TH day of MARCH, 2012.


 WISCONSIN REGISTERED LAND SURVEYOR
 Steven C. DeJong, S-2791

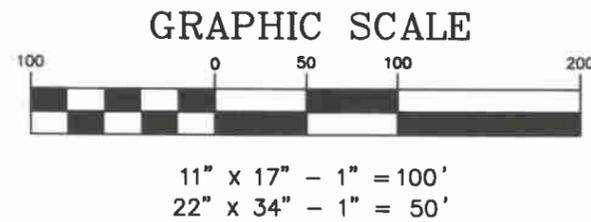

CSR 2199

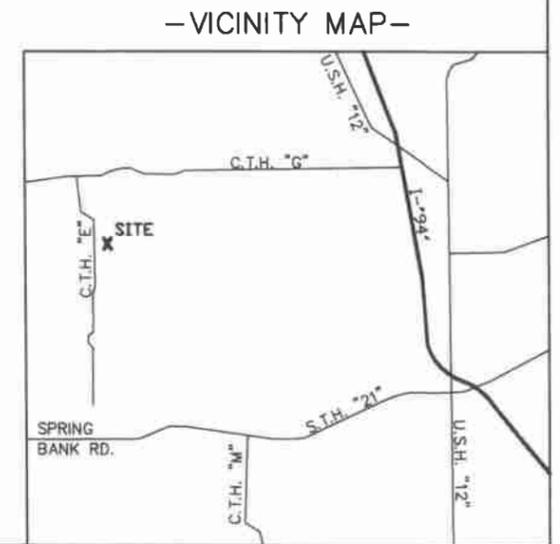

SITE NAME: TOMAH		SITE ADDRESS: 8336 COUNTY ROAD "E" TUNNEL CITY, WI 54662		AS-BUILT SURVEY FOR US CELLULAR	
SITE NUMBER: 774326					
MERIDIAN SURVEYING, LLC				BEING A PART OF THE NW1/4 OF THE NW1/4, SECTION 10, T.18N., R.2W., TOWN OF GREENFIELD, MONROE COUNTY, WISCONSIN	
				N8774 Firelane 1 Office: 920-993-0881 Menasha, WI 54952 Fax: 920-273-6037	
1	12-29-11	Preliminary Survey	J.D.		
NO.	DATE	DESCRIPTION	BY		
DRAWN BY: J.D.		FIELD WORK DATE: 12-21-11			
CHECKED BY: S.C.D.		FIELD BOOK: M-23, PG.32-33			
JOB NO.: 6654-B1020		SHEET 1 of 2			

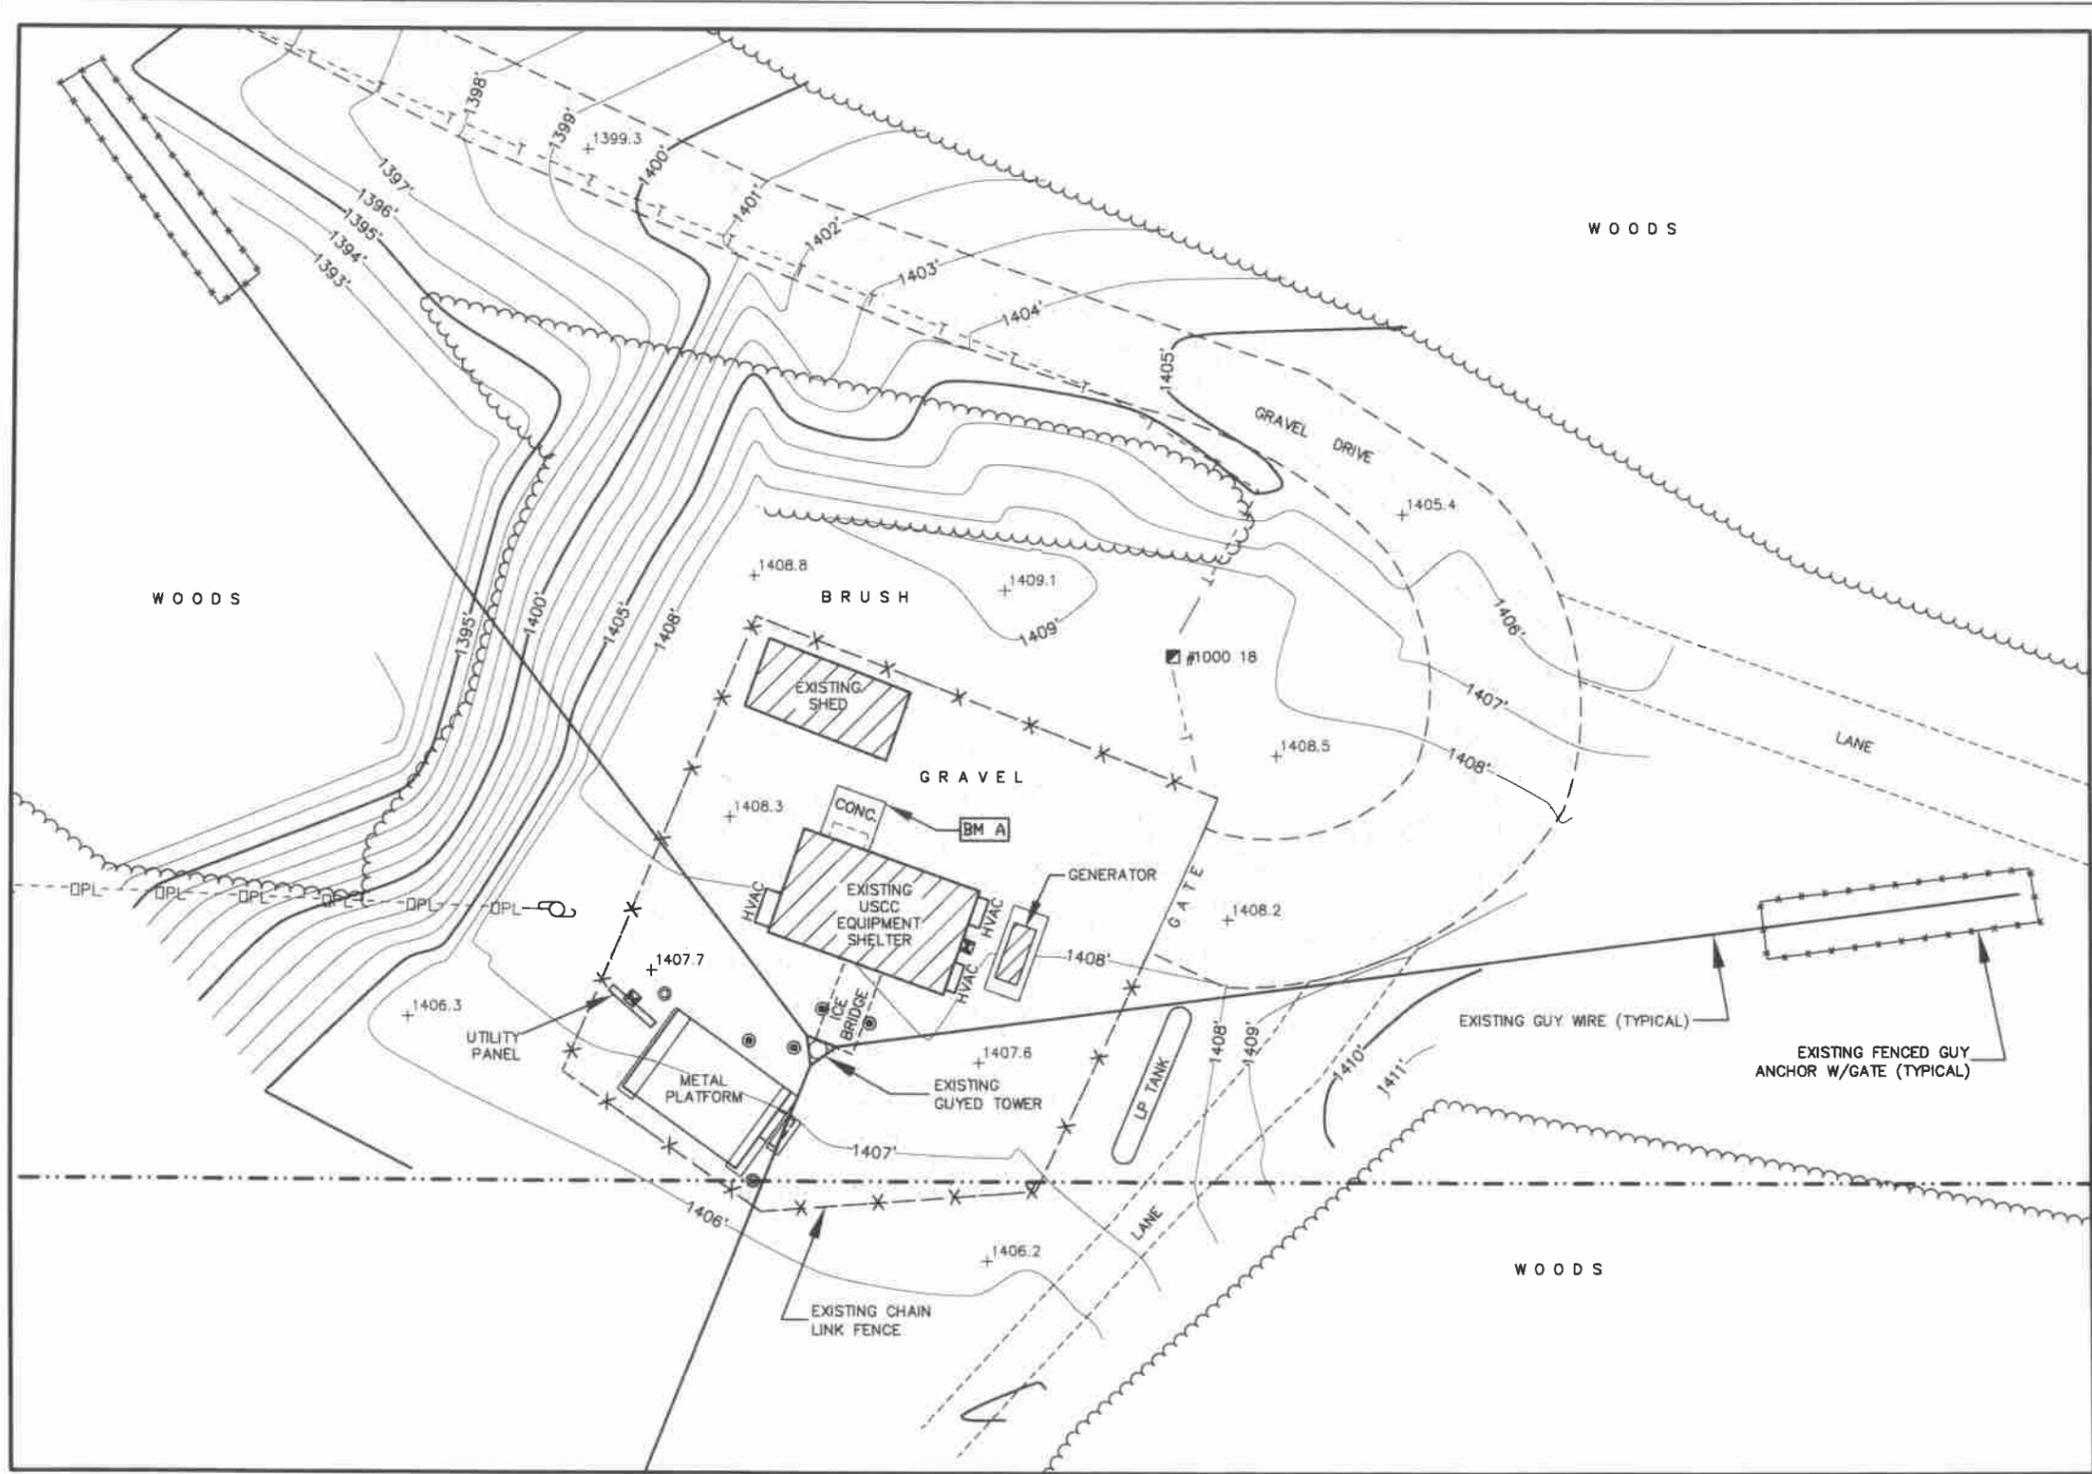


- LEGEND-**
- = 1" IRON PIPE FOUND
 - () = RECORDED INFORMATION
 - ⊕ = COUNTY MONUMENT FOUND
 - ⊠ = ELECTRIC METER
 - ⊡ = TELEPHONE PEDESTAL
 - ⊙ = METAL POST
 - ⊗ = TEST WELL
 - ⊕ = EXISTING POWER POLE
 - OPL- = OVERHEAD ELECTRIC
 - T- = BURIED TELEPHONE
 - = PROPERTY LINE

PARCEL 1
 A PARCEL OF LAND LOCATED IN THE NORTHWEST QUARTER OF THE NORTHWEST QUARTER OF SECTION 10, TOWNSHIP 18 NORTH, RANGE 2 WEST, TOWN OF GREENFIELD, MONROE COUNTY, WISCONSIN, DESCRIBED AS FOLLOWS: COMMENCING AT THE WEST QUARTER CORNER OF SAID SECTION 10, THENCE NORTH 1 DEGREE 51 MINUTES 39 SECONDS EAST A DISTANCE OF 1300.44 FEET TO THE SOUTHWEST CORNER OF THE SAID NORTHWEST QUARTER OF THE NORTHWEST QUARTER; THENCE SOUTH 88 DEGREES 20 MINUTES 12 SECONDS EAST, ALONG THE SOUTH LINE OF THE SAID NORTHWEST QUARTER OF THE NORTHWEST QUARTER, A DISTANCE OF 100.82 FEET, TO THE POINT OF BEGINNING; THENCE NORTH 1 DEGREE 39 MINUTES 48 SECONDS EAST, A DISTANCE OF 152.28 FEET; THENCE SOUTH 88 DEGREES 20 MINUTES 12 SECONDS EAST, A DISTANCE OF 582.82 FEET; THENCE SOUTH 1 DEGREE 39 MINUTES 48 SECONDS WEST, A DISTANCE OF 152.28 FEET, TO THE SOUTH LINE OF THE SAID NORTHWEST QUARTER OF THE NORTHWEST QUARTER; THENCE NORTH 88 DEGREES 20 MINUTES 12 SECONDS WEST, ALONG SAID SOUTH LINE, A DISTANCE OF 582.82 FEET, TO THE POINT OF BEGINNING. Containing 2.037 acres, more or less.

PARCEL 2
 A NON-EXCLUSIVE EASEMENT FOR INGRESS, EGRESS, AND UTILITIES OVER, UNDER, AND UPON A PARCEL OF LAND 16 FEET WIDE, LYING 8 FEET EITHER SIDE OF THE FOLLOWING DESCRIBED CENTERLINE: COMMENCING AT THE NORTHEAST CORNER OF PARCEL 1 AFORSAID; THENCE NORTH 88 DEGREES 20 MINUTES 12 SECONDS WEST ALONG THE NORTH LINE OF SAID PARCEL 1, A DISTANCE OF 292.83 FEET TO THE POINT OF BEGINNING OF SAID CENTERLINE; THENCE NORTH 54 DEGREES 38 MINUTES 18 SECONDS WEST, A DISTANCE OF 158.14 FEET; THENCE NORTH 74 DEGREES 15 MINUTES 24 SECONDS WEST, A DISTANCE OF 335.00 FEET; THENCE NORTH 69 DEGREES 30 MINUTES 48 SECONDS WEST, A DISTANCE OF 176.00 FEET; THENCE NORTH 61 DEGREES 26 MINUTES 52 SECONDS WEST, A DISTANCE OF 185.69 FEET; THENCE SOUTH 81 DEGREES 07 MINUTES 02 SECONDS WEST, A DISTANCE OF 40 FEET, MORE OR LESS, TO THE CENTERLINE OF C.T.H. "E" AND THE POINT OF TERMINATION OF SAID CENTERLINE.

Intending to describe a 16.00 foot wide easement parcel, the westerly end of which adjoins the centerline of C.T.H. "E" and the easterly end of which adjoins the north line of said Parcel 1.

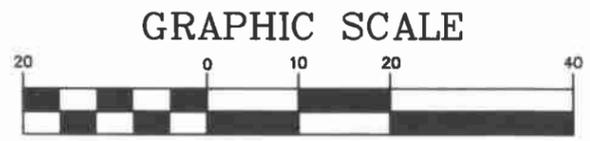

11" x 17" - 1" = 20'
 22" x 34" - 1" = 10'

BENCHMARK INFORMATION
 SITE BENCHMARK: (BM A)
 TOP OF NORTHEAST CORNER OF CONCRETE PAD AT EQUIPMENT SHELTER ENTRANCE
 ELEVATION: 1408.72'

BEARINGS REFERENCED TO THE MONROE COUNTY COORDINATE SYSTEM AND THE WEST LINE OF THE NW1/4, SECTION 10, T.18N., R.2W. WHICH BEARS: N00°-15'-11"E

I, Steven C. DeJong, hereby certify that none of the property described hereon is within a flood plain or wetlands area as defined by FEMA or Wisconsin DNR.

SURVEYOR'S CERTIFICATE
 I, Steven C. DeJong, Wisconsin Registered Land Surveyor of Meridian Surveying, LLC, certify that I have surveyed the described property and that the map shown is a true and accurate representation thereof to the best of my knowledge and belief.

Dated this 26TH day of MARCH, 2012.

StCDeJ
 WISCONSIN REGISTERED LAND SURVEYOR
 Steven C. DeJong, S-2791



MERIDIAN SURVEYING, LLC

88774 Firelane 1 Office: 920-993-0881
 Menasha, WI 54952 Fax: 920-273-6037

AS-BUILT SURVEY FOR US CELLULAR
 BEING A PART OF THE NW1/4 OF THE NW1/4, SECTION 10, T.18N., R.2W., TOWN OF GREENFIELD, MONROE COUNTY, WISCONSIN

NO.	DATE	DESCRIPTION	BY
1	12-29-11	Preliminary Survey	J.D.
DRAWN BY: J.D.		FIELD WORK DATE: 12-21-11	
CHECKED BY: S.C.D.		FIELD BOOK: M-23, PG.32-33	
JOB NO.: 6654-B1020		SHEET 2 OF 2	