

# RECORD OF SURVEY

Located in the SW $\frac{1}{4}$ -SW $\frac{1}{4}$  Sec 18 & NW $\frac{1}{4}$ -NW $\frac{1}{4}$  of Sec. 19, T15N-R1W, Wellington, & NE $\frac{1}{4}$ -NE $\frac{1}{4}$  Sec. 24, T15N-R2W, Town of Sheldon Monroe County, WI.

- ⊙=Existing Cast Iron County Monument
- =Existing 1 $\frac{1}{4}$ " round iron bar
- ⊙=Set  $\frac{3}{4}$ " round iron bar at road P.I. curves "D" & "E"
- ⊙=Set 1"x30" iron pipe at road P.I. curve "A"
- ⊙=Set  $\frac{3}{4}$ "x24" hexagon iron bar & at road P.I. curve "B"
- =Set mag nail
- ⊙=Set  $\frac{1}{2}$ "x12" iron bar at road P.I. "C"


Bearings referenced to the North line of the NW $\frac{1}{4}$  Sec. 19, ASSUMED to bear N89°25'13"W.

The purpose of this survey is to show existing roadways.

SCALE: 1"=200'



*Gary L. Dechant*  
 WISCONSIN  
 GARY L. DECHANT  
 S-1744  
 CAMP DOUGLAS, WI  
 LAND SURVEYOR  
 November 15, 2013

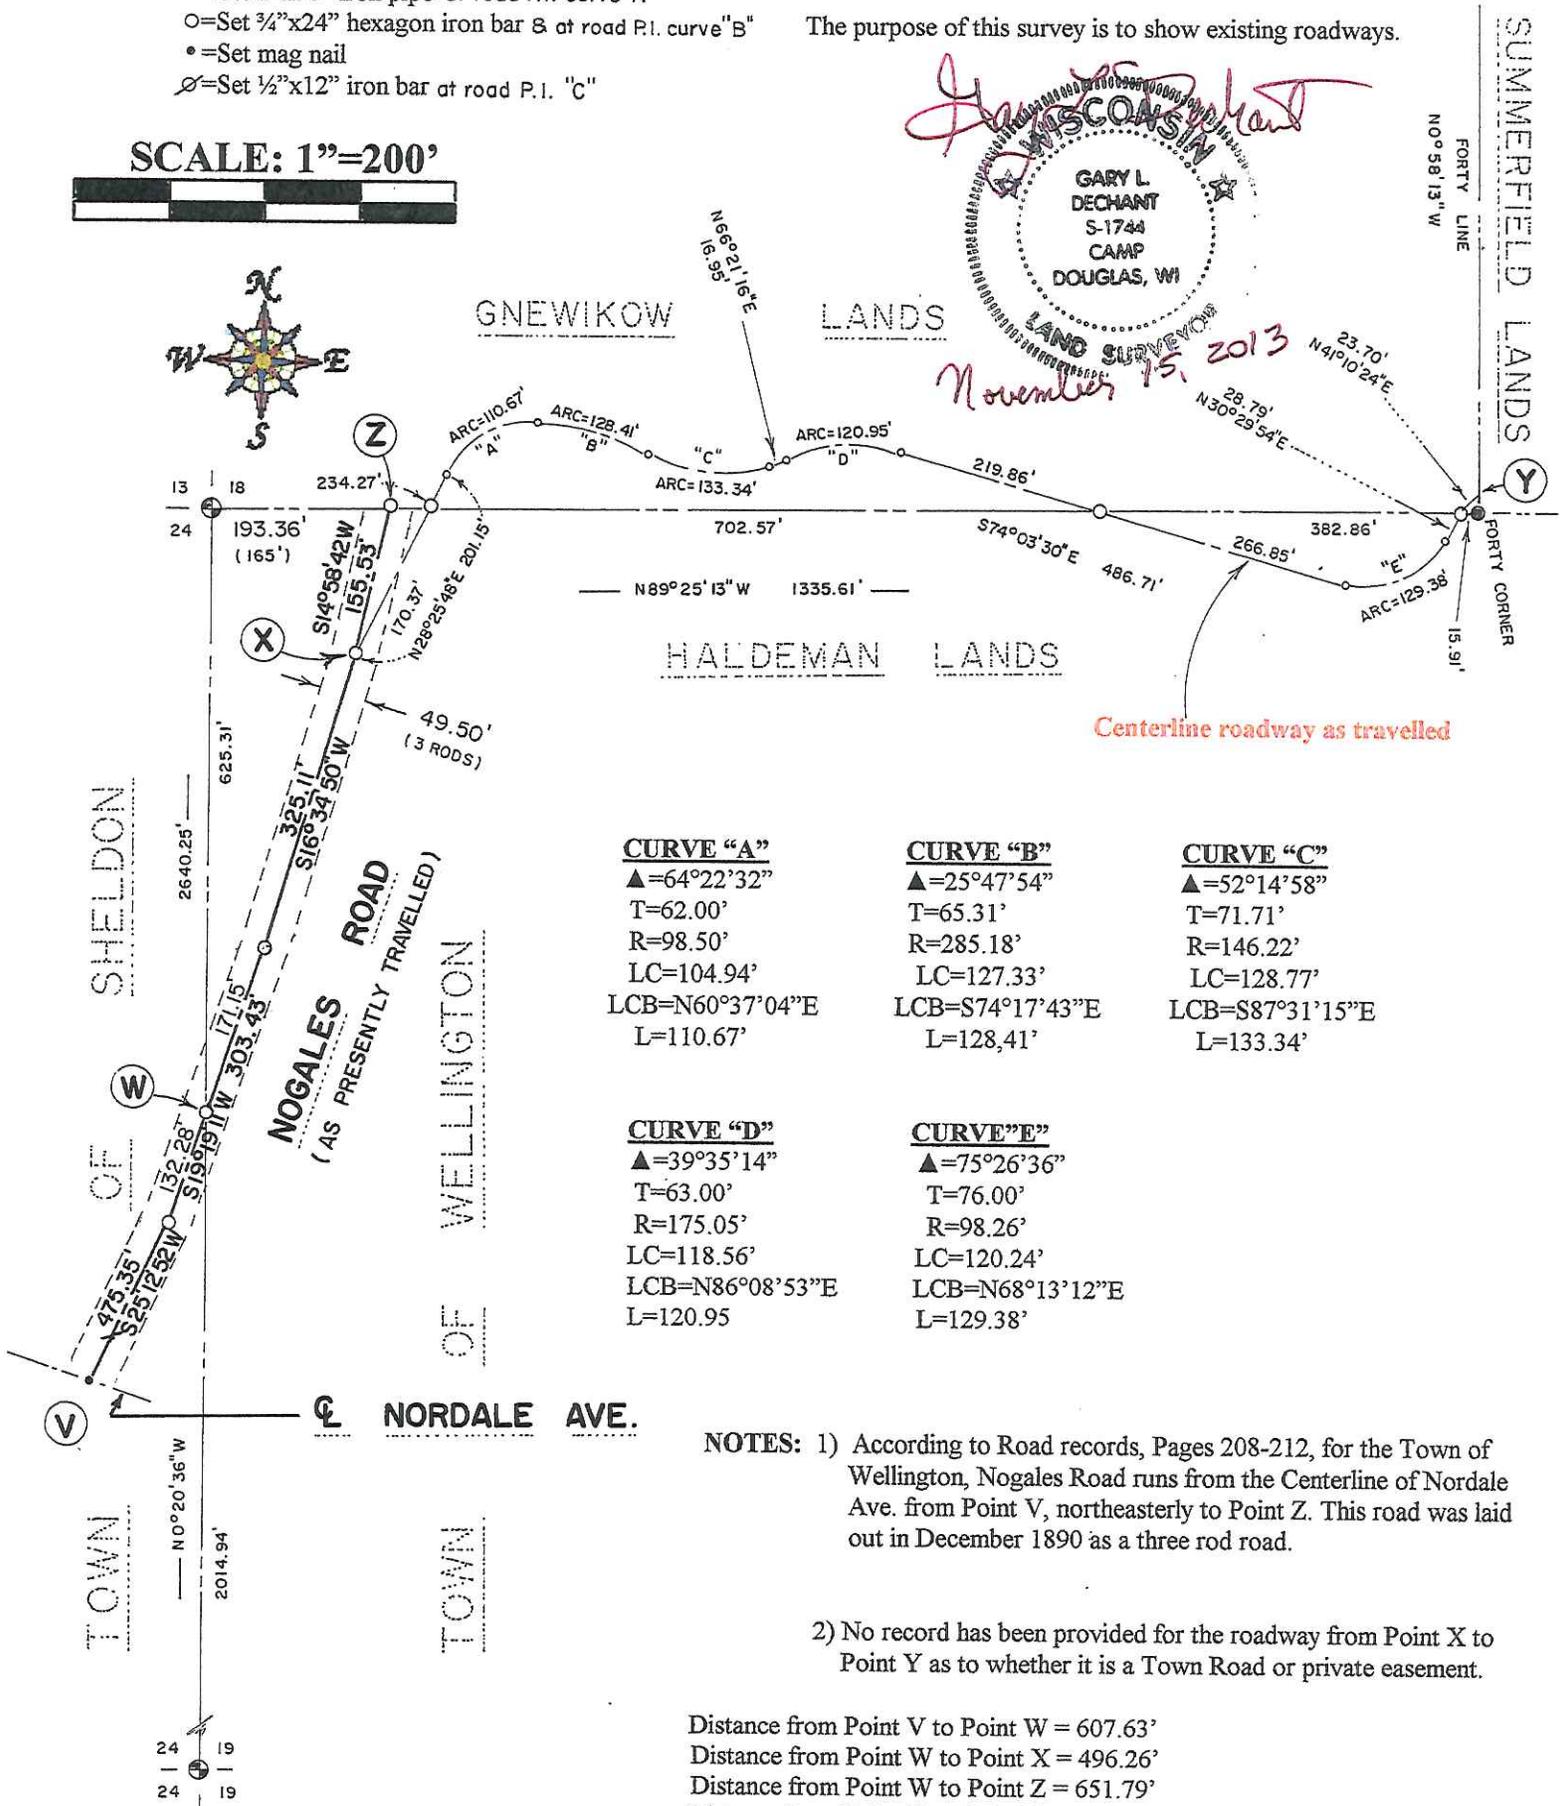

<p><b>CURVE "A"</b>                  ▲=64°22'32"                  T=62.00'                  R=98.50'                  LC=104.94'                  LCB=N60°37'04"E                  L=110.67'</p>	<p><b>CURVE "B"</b>                  ▲=25°47'54"                  T=65.31'                  R=285.18'                  LC=127.33'                  LCB=S74°17'43"E                  L=128.41'</p>	<p><b>CURVE "C"</b>                  ▲=52°14'58"                  T=71.71'                  R=146.22'                  LC=128.77'                  LCB=S87°31'15"E                  L=133.34'</p>
<p><b>CURVE "D"</b>                  ▲=39°35'14"                  T=63.00'                  R=175.05'                  LC=118.56'                  LCB=N86°08'53"E                  L=120.95'</p>	<p><b>CURVE "E"</b>                  ▲=75°26'36"                  T=76.00'                  R=98.26'                  LC=120.24'                  LCB=N68°13'12"E                  L=129.38'</p>	

**NOTES:** 1) According to Road records, Pages 208-212, for the Town of Wellington, Nogales Road runs from the Centerline of Nordale Ave. from Point V, northeasterly to Point Z. This road was laid out in December 1890 as a three rod road.

2) No record has been provided for the roadway from Point X to Point Y as to whether it is a Town Road or private easement.

- Distance from Point V to Point W = 607.63'
- Distance from Point W to Point X = 496.26'
- Distance from Point W to Point Z = 651.79'
- Distance from Point X to Point Y = 1380.05'
- Distance from Point W to Point Y = 1876.31'