


- LEGEND**
These standard symbols will be found in the drawing
- STORM SEWER
 - OVERHEAD UTILITIES
 - BURIED ELECTRIC
 - BURIED GAS
 - FIBER OPTICS
 - FENCE LINE
 - EDGE OF BITUMINOUS
 - CONTOUR LINE
 - CIRCULAR CATCH BASIN
 - STORM MANHOLE
 - HYDRANT
 - ELECTRIC METER
 - LIGHTPOLE
 - POWERPOLE
 - FLOOD LIGHT
 - GUY WIRE
 - TELEPHONE PEDESTAL
 - GUARD POST
 - FIRE MAIN POST
 - MONITORING WELL
 - SIGN
 - ROOF DRAIN
 - BUSH/SHRUB
 - TREE
 - PINE TREE
 - COMPUTED CORNER LOCATION
 - 3/4" O.D. IRON BAR FOUND
 - HARRISON MONUMENT FOUND

UNDERGROUND UTILITIES
THESE RECORD DRAWINGS HAVE BEEN PREPARED, IN PART, ON THE BASIS OF INFORMATION COMPILED AND FURNISHED BY OTHERS. THE SURVEYOR AND ARCHITECT WILL NOT BE RESPONSIBLE FOR ANY ERRORS OR OMISSIONS WHICH HAVE BEEN INCORPORATED INTO THIS DOCUMENT AS A RESULT.
SOME UTILITIES HAVE BEEN LOCATED BY MAPS PROVIDED BY OTHERS - LOCATIONS ARE APPROXIMATE.
PRIVATE UTILITIES MAY EXIST BUT ARE NOT SHOWN ON MAP. CONTACT DIGGERS HOTLINE FOR LOCATIONS.
FIELD VERIFY SANITARY AND STORM SEWER PIPE SIZE AND LOCATION.
UNDERGROUND UTILITIES SHOWN ON THIS MAP ARE BASED IN PART ON MARKINGS BY DIGGERS HOTLINE. (TICKET #20164606056, #20164605986)


DESCRIPTION
LOCATED IN THE SOUTHWEST 1/4 OF THE NORTHWEST 1/4 OF SECTION 8 AND THE SOUTHEAST 1/4 OF THE NORTHEAST 1/4 OF SECTION 7, TOWNSHIP 17 NORTH, RANGE 3 WEST, CITY OF SPARTA, MONROE COUNTY, WISCONSIN.

BENCH MARK
ELEVATIONS ARE REFERENCED TO NAVD 88 DATUM.
BENCHMARK #1
BURY BOLT OF HYDRANT LOCATED APPROXIMATELY 36 FEET NORTH OF THE NORTHWEST CORNER OF GARAGE IN BACK OF CAMPUS BUILDING.
ELEVATION = 804.67
BENCHMARK #2
BURY BOLT OF HYDRANT LOCATED APPROXIMATELY 48 FEET EAST AND APPROXIMATELY 20 FEET NORTH OF THE NORTHWEST CORNER OF THE MAIN CAMPUS BUILDING.
ELEVATION = 805.05
BENCHMARK #3
RETIKEX BENCHMARK #1, SOUTHEAST BOLT ON LIGHTPOLE LOCATED APPROXIMATELY 100 FEET NORTHEAST OF THE NORTHEAST CORNER OF BUILDING.
ELEVATION = 806.87

SURVEYOR'S CERTIFICATE
I, DONALD J. BUZA, PROFESSIONAL LAND SURVEYOR DO HEREBY CERTIFY THAT THIS IS A TRUE AND CORRECT COPY OF A TOPOGRAPHICAL SURVEY AS DONE UNDER MY DIRECTION ON NOVEMBER 16, 2016.
DATED THIS 22ND DAY OF DECEMBER, 2016
Donald J. Buza
DONALD J. BUZA (PRO)
PROFESSIONAL LAND SURVEYOR
WISCONSIN
DONALD J. BUZA
S-2338
CLUSTER
WI
LAND SURVEYOR

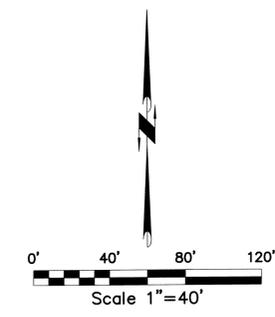

POINT OF BEGINNING, INC. HOLDS THE RIGHTS TO COPYRIGHT IN AND TO THESE PLANS, DRAWINGS AND DOCUMENTS. NO REPRODUCTION, COPYING, ALTERATION, MODIFICATION, USAGE, INCORPORATION INTO OTHER DOCUMENTS OR ANY USE OF THE SAME MAY OCCUR WITHOUT THE PRIOR WRITTEN PERMISSION OF POINT OF BEGINNING, INC.
© 2016 POINT OF BEGINNING, INC.

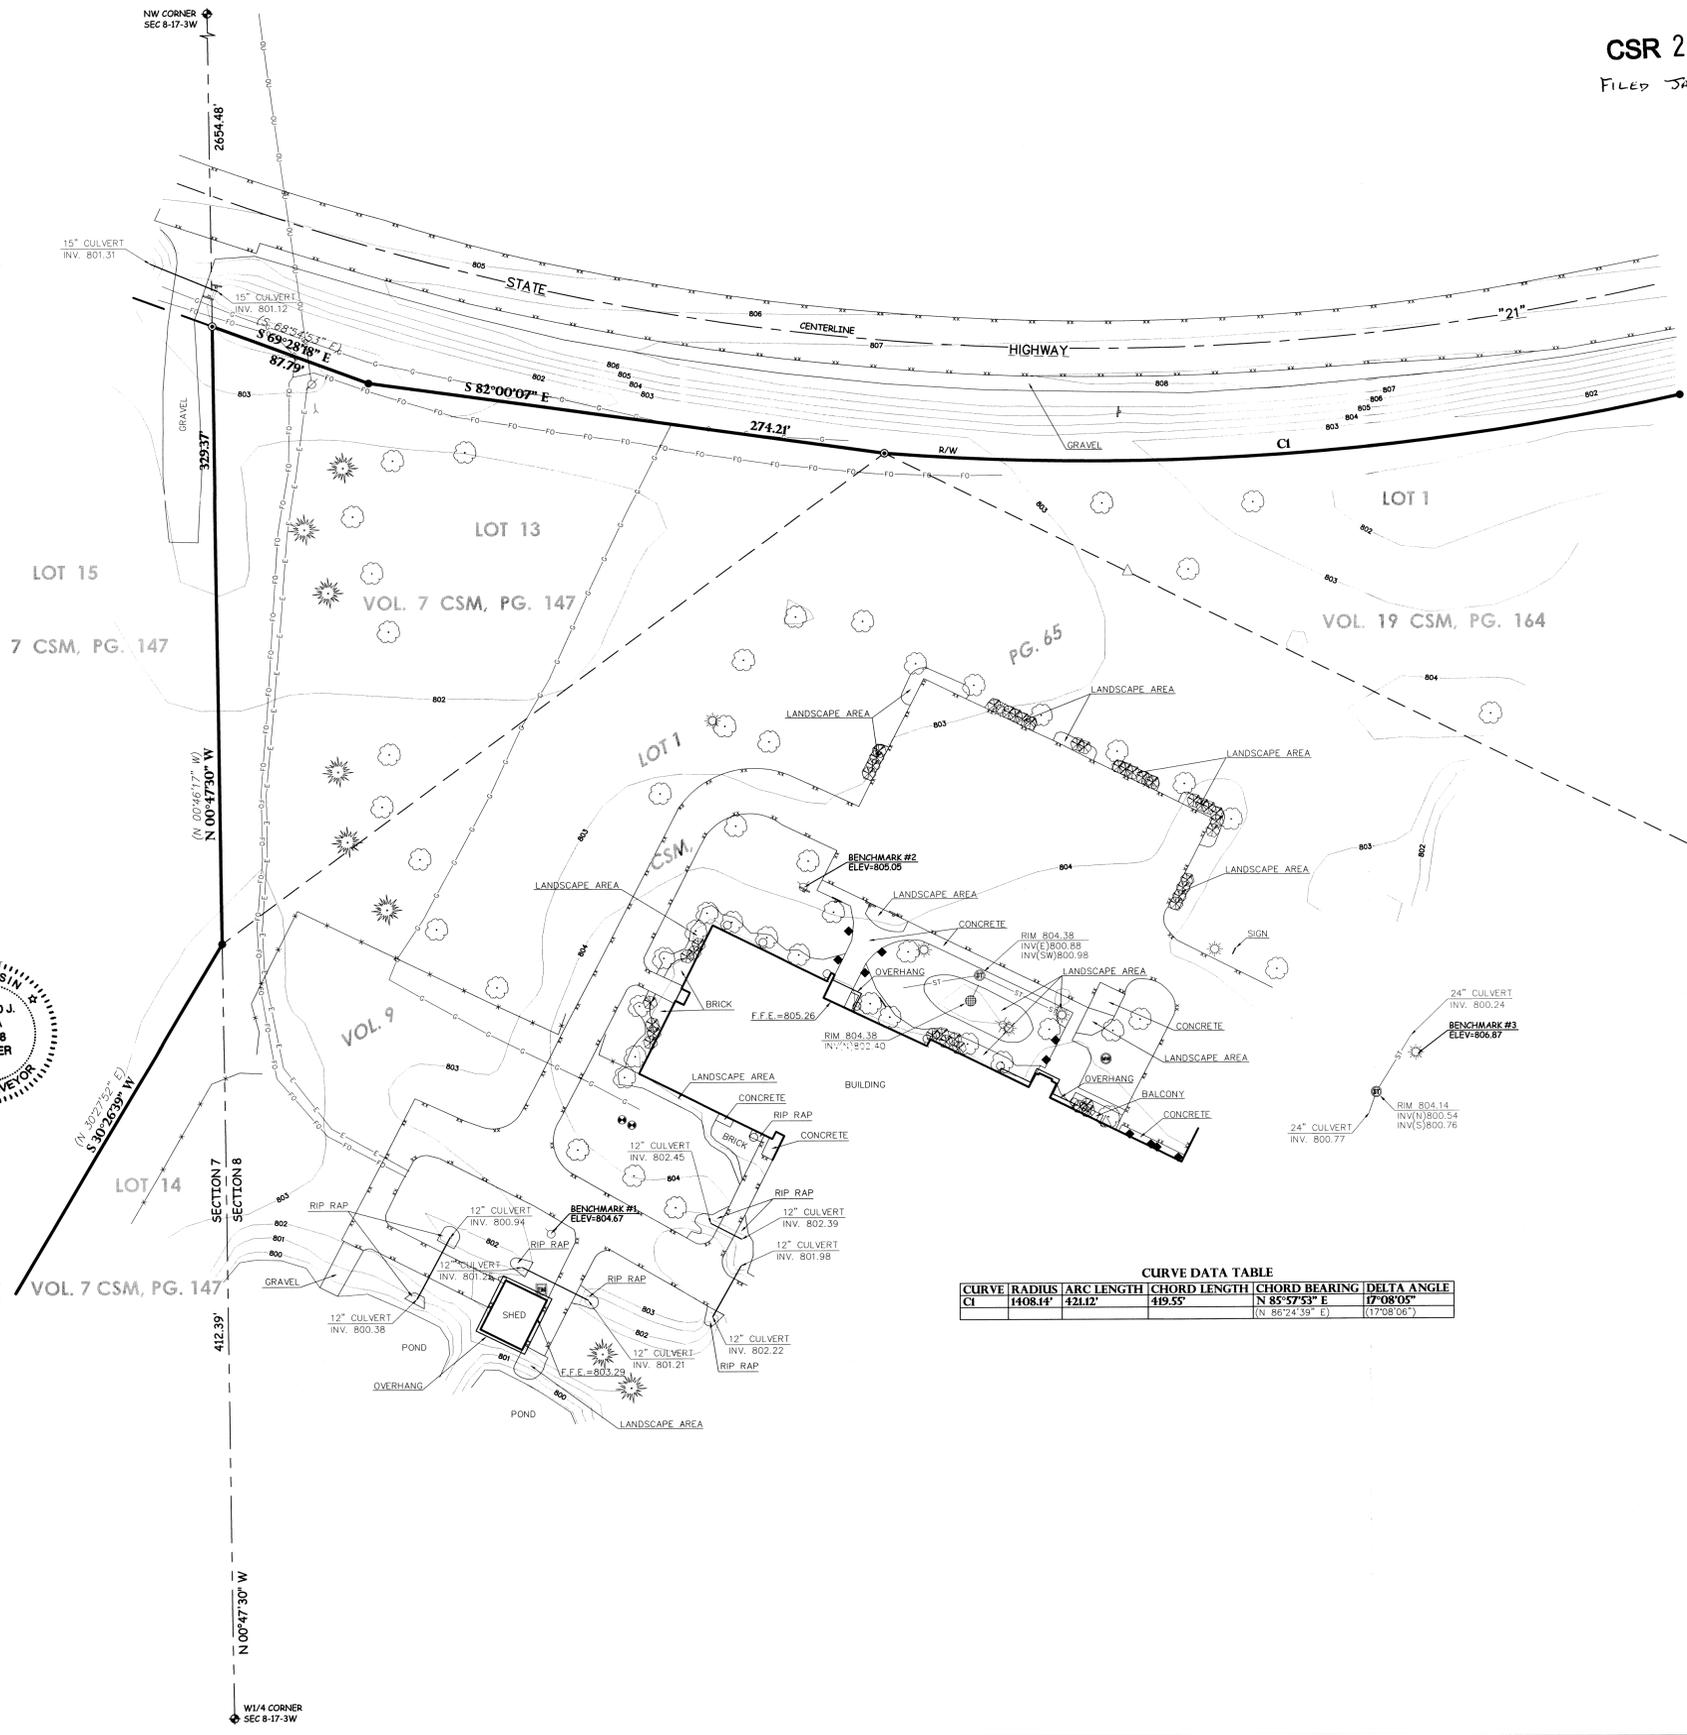

CURVE DATA TABLE

CURVE	RADIUS	ARC LENGTH	CHORD LENGTH	CHORD BEARING	DELTA ANGLE
C1	1408.14'	421.12'	419.55'	N 85°57'53" E	17°08'05"
				(N 86°24'39" E)	(17°08'05")

REVISIONS

CHECKED:	DONALD J. BUZA
DRAWN:	TRAVIS OLDS
DATE:	NOVEMBER 21, 2016
PROJECT NO.	16.504

TOPOGRAPHIC MAP

HSR ASSOCIATES, INC.
WTC CAMPUS
CITY OF SPARTA
MONROE COUNTY, WISCONSIN

Civil Engineering
Land Surveying
Landscape Architecture
5709 Windy Drive, Suite D
Stevens Point, WI 54482
715.344.9999 (P) 715.344.9922 (F)



TOPO