

**U.S. PUBLIC LAND CORNER
MAINTENANCE**

75

**Corner ID: E1/4 Sec. 19, T17N-R3W
21703192000**

<u>DATE</u>	<u>CREW</u>	<u>MONUMENT INFO</u>
March 10, 2020	Zachariah P. Dechant Gary L. Dechant	Existing Harrison top broke off, 322' south of Havendale Ave., 13 north of gravel roadway, 102' north of steel power pole, 1/2' west of square cedar corner post between 11009 & 11047 Havendale Ave

	<u>Compass Bearing</u>	<u>Distance</u>
1) Set 3/4"x24' round iron bar, down 6", 1/2' west cedar fence	North	15.41'
2) Set 3/4"x24" round iron bar, down 6"	S46E	40.80'
3) Set 3/4"x24" round iron bar, down 6"	S18W	36.42'
4) Existing 3/4" round iron bar	West	24.80' (24.77')



March 17, 2020

CERTIFICATE

I, Nicholas M. Hillmer, do hereby certify that this document and the data contained herein was prepared by me or under my direct supervision and that I am a duly Licensed Land Surveyor under the laws of the State of Wisconsin.

Dated this 23rd day of May, 2013

Nick Hillmer

Nicholas M. Hillmer, P.L.S. 2909
Anderson Engineering of Minnesota, LLC.

CERTIFIED LAND CORNER

History of corner established since Original Government Survey

In 1976 Harley Sime found and accepted a pipe used in previous surveys. Sime replaced the pipe with a Harrison monument.

Description of evidence found

On January 22nd, 2013, Anderson Engineering of Minnesota located the Harrison monument with the top missing 0.3 feet below grade and 0.7 feet east of a witness post with a survey marker sign. The monument is 0.2 feet west of a wood fence post corner of a fence that runs north and east. The monument is 12 feet north of an east-west road.

No. 75 P.3
21703192000



Description of corner and witness monuments, references and accessories used to perpetuate the original or re-established location of this corner:

Witnesses to corner location:


Nick Hillmer
Josh Oslund
Dan Greenwald

MONROE COUNTY
COORDINATE SYSTEM
NAD 1983 (2007)


HARRISON MONUMENT
Northing (Y) 376516.93
Easting (X) 637142.74

Base Station - 22 182W
Northing (Y) 408053.25
Easting (X) 679287.00

All distances are shown in U.S. Survey Feet.
Bearings are for tie reference purposes only.
Coordinates were derived from RTK GNSS procedures.

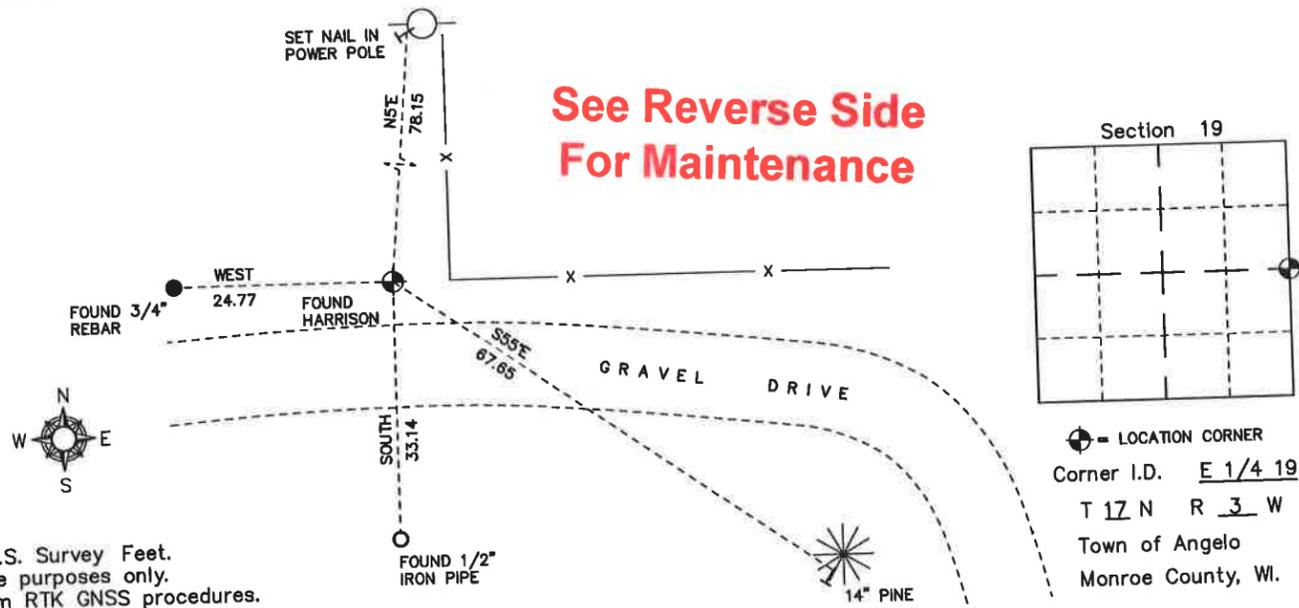

**See Reverse Side
For Maintenance**

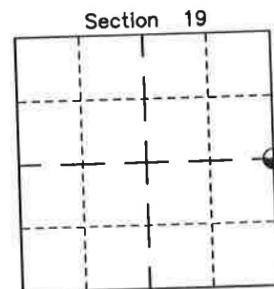

● - LOCATION CORNER
Corner I.D. E 1/4 19
T 17 N R 3 W
Town of Angelo
Monroe County, WI.

I, Harley A. Sime, do hereby certify that on the 4th day of June 19 76, I found (evidence) ~~no evidence~~ of the West 1/4 corner of Section 20, T 17 N, R 3 W, Fourth Principal Meridian, and I re-established said corner according to the Wisconsin Statutes as shown and described hereon.

Dated this 8th day of April 19 77.

County Surveyor
Title

History of original corner establishment:

**See Reverse Side
For Maintenance**

Description of corner evidence found:

Removed a 2" iron pipe that had been used in previous surveys and replaced it with a Harrison marker.

1993 UPDATE: While doing a survey on a nearby parcel, I found this Harrison damaged and in need of new ties. I found the Harrison with the top 4"± broken off. I left the remaining portion of the Harrison in as the corner and established new ties as shown below.

Bryan H. Meyer
Bryan H. Meyer
Registered Land Surveyor

Description of corner and witness monuments, references and accessories used to perpetuate the original or re-established location of this corner:

Set nail in West side of power pole

NOTE: This is the same power pole as shown on previous tie sheet!

Set sign 1'± West of Harrison.

Existing cast iron Harrison marker with top 4"± broken off.

Set 3/4" x 24" round iron bar

Existing 1/2" iron pipe, up 1'±.

Set nail in Northwest side of 14" Norway Pine (no blaze).


Witnesses to corner location:

Jung

Dechant



1993 UPDATE CREW: Meyer, Lobe
June 23, 1993
Partly Sunny, 80°±

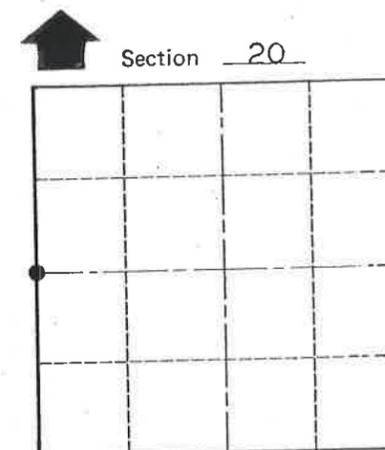

● = LOCATION CORNER

T 17 N R 3 W

WISCONSIN

SURVEY CONTROL ORDER

Horizontal	_____
Vertical	_____

WISCONSIN COORDINATE SYSTEM

Corner	East (X)	North (Y)	Elevation (Z)	Zone
Control Sta. Name				

City, Village or Town Angelo

County of Monroe

COUNTY SURVEYOR FORM NO. 1

CERTIFICATE

CERTIFIED LAND CORNER

No. 75

See New Sheet

I, Harley A. Sime, do hereby certify that on the 4th day of June, 19 76, I found (evidence) ~~(no evidence)~~ of the West 1/4 corner of Section 20, T 17 N, R 3 W, Fourth Principal Meridian, and I re-established said corner according to the Wisconsin Statutes as shown and described hereon.

Dated this 8th day of April 19 77.

History of original corner establishment:

Description of corner evidence found:

Removed a 2" iron pipe that had been used in previous surveys and replaced it with a Harrison marker.

County Surveyor Approved: HARLEY A. SIME
Title MONROE CO. SURVEYOR

COUNTY SURVEYOR FORM NO. 1



Description of corner and witness monuments, references and accessories used to perpetuate the original or re-established location of this corner:

Set Harrison up 1".

Witnesses to corner location:

Jung

Dechant

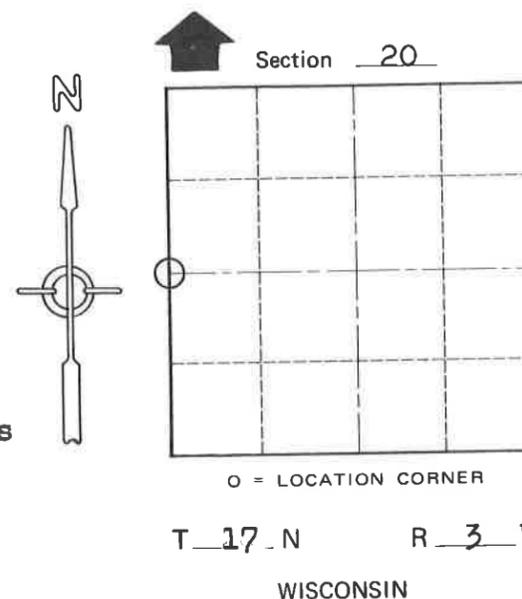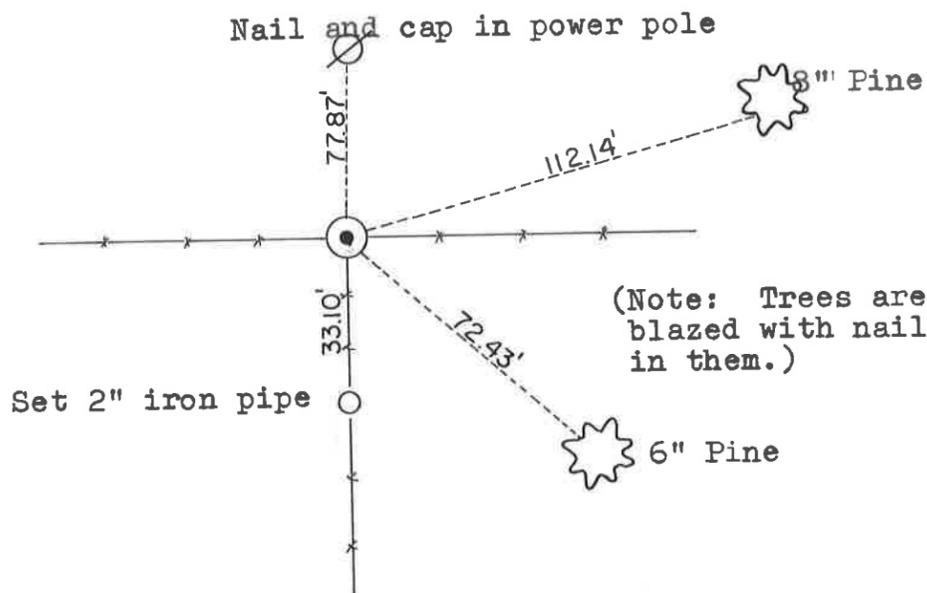

SURVEY CONTROL ORDER

Horizontal _____
Vertical _____

WISCONSIN COORDINATE SYSTEM

Corner	East (X)	North (Y)	Elevation (Z)	Zone
Control Sta. Name				

City, Village or Town Angelo

County of Monroe